

FEB 17 1994

001 PAGE 51

LAND CORNER RECORDATION CERTIFICATE
Filing Requirement of Act 74, Mich. P.A. 1970

COMMISSION
For corners in

RECORDED

Alcona
(County)

Located In:

Corner Code #

Remon Liber 1 Page 51

Dec 22 1 15 PM '93

1. Public Land Survey T R
T R
T R
T R
2. Property Controlling S 1 T 26N R 8E
in Section S T R
3. Miscellaneous S T R
Property in Sec. S T R

Other #4

L-2

David B. Guthrie
REGISTER OF DEEDS
ALCONA COUNTY, MICHIGAN

Register of Deeds Stamp & File Number

4. Lot No. , Recorded Plat
5. Private Claims

I, David B. Guthrie in a field survey on December 21, 19 93, do hereby certify that under requirements of P.A. 74, Michigan P.A. of 1970, the corner points mentioned in lines 1 and 2 above were in conformance with regulations and rules therefore as required in the current manual of survey instructions of the United States Department of the Interior, Bureau of Land Management or by a decree of a Court of Law and/or that the corner points mentioned in lines 3, 4 and 5 above were in conformance with the rules of the Michigan Board of Land Surveyors or by a Decree of a Court of Law; established, re-established, monumented, re-monumented, recovered, found as expressed below:

NOTE: Not more than 4 corners, all in the same town and range, may be recorded on this certificate.

A. Description of original monument and accessories and/or subsequent restoration:

N/A


B. Description of corner evidence found and/or method applied in restoring or reestablishing corner:

Set corner at the intersection of the 1/4 lines based upon the locations of the existing North, East and West 1/4 corners and the placement of the lost South 1/4 corner by single proportion between the recovered Southeast and Southwest section corners.

C. Description of monument for corner and accessories established to perpetuate locating the position of the corner:

Set 1/2" x 24" Iron Rod with a 3" aluminum cap stamped to identify the corner. Referenced

- S78°09'58"E - Concrete Monument - 3.63 Feet by D.R. MacNeill and Assoc.
N88°19'38"E - 1/2" Iron Rod - 10.83 Feet by JAMES L. Schwandt
N45°W - 12" Balsam 23.64 Feet
S85°W - 4" Balsam - 20.90 Feet
N75°W - 5" Cedar - 44.25 Feet
N02°W - 8" Spruce - 74.60 Feet

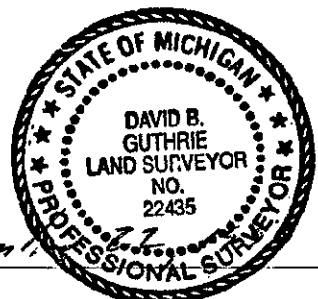

Signed by

David B. Guthrie

Date

Dec 22

Surveyor's Michigan License No. 22435