

1993 Alcona County Remonumentation Corner
LAND CORNER RECORDATION CERTIFICATE
 Filing Requirement of Act 74, Mich. P.A. 1970

for corners in

Alcona
 (County)

Located In:

Corner Code ##

Remon 1 Page 15

Dec 20 1 18 PM '93

David B. Guthrie
 REGISTER OF DEEDS
 ALCONA COUNTY, MICHIGAN

Register of Deeds Stamp & File Number

Public Land Survey T 28N R 7E M-8.5 (M.P.)
 T R
 T R
 T R
 T R
 Property Controlling S T R
 in Section S T R
 Miscellaneous S T R
 Property in Sec. S T R

1. Lot No. _____, Recorded Plat _____
 2. Private Claims _____

David B. Guthrie a field survey on September 21, 19 93,
 do hereby certify that under requirements of P.A. 74, Michigan P.A. of 1970, the corner points mentioned
 in lines 1 and 2 above were in conformance with regulations and rules therefore as required in the
 current manual of survey instructions of the United States Department of the Interior, Bureau of Land
 Management or by a decree of a Court of Law and/or that the corner points mentioned in lines 3, 4 and 5
 above were in conformance with the rules of the Michigan Board of Land Surveyors or by a Decree of a
 Court of Law; established, re-established, monumented, re-monumented, recovered, found as
 expressed below:

NOTE: Not more than 4 corners, all in the same town and range, may be recorded
 on this certificate.

A. Description of original monument and accessories and/or subsequent restoration:

1839: G.L.O. Survey by Lewis Clason - Set Post
 1966: Survey by James L. Scott - Replaced corner, no references
 1975: Survey by David B. Guthrie - Set concrete monument and referenced.
 1988: Survey by David B. Guthrie - Found concrete monument, verified
 prior references.
 1992: Survey by David B. Guthrie - Found concrete monument, verified
 prior references.

B. Description of corner evidence found and/or method applied in restoring or reestablishing corner:

1993: Found concrete monument

SURVEY &
 REMONUMENTATION


1993

COMMISSION

C. Description of monument for corner and accessories established to perpetuate locating the position of the corner:

1993: Existing 4" x 36" Concrete Monument, placed a 3" aluminum cap stamped to identify the corner.

Referenced:
 N32°W - 16" Locust - 46.85 Feet
 N17°E - 16" Spruce - 82.60 Feet
 N52°E - S.W. Cor. Hse. - 44.25 Feet
 S80°E - 16" Ash - 18.95 Feet

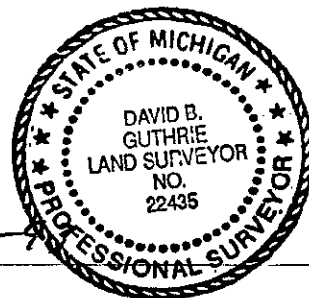

Signed by

David B. Guthrie

Date

12-20-93

Surveyor's Michigan License No. 22435