

Approved by Alger County
Land Survey Remonumentation
Peer Group Under Act 345 of
P.A. of 1990 On 12-12-1995

Gerald Carlson
Chairman

For corners in

Alger

(County)

Located in:

Corner Code #

LAND CORNER RECORDATION CERTIFICATE
Filing Requirement of Act 74, Mich. P.A. 1970

**SURVEY &
DOCUMENTATION**

JAN 23 1996

COMMISSION

4-342

REC'D and FILED

JAN 23 1996

2:45 p.m.

COMM. DIVISION, County Clerk
ALGER COUNTY, MI

Register of Deeds Stamp & File Number

1. Public Land Survey

T 45N R 21W

T 45N R 22W

T _____ R _____

T _____ R _____

S _____ T _____ R _____

S _____ T _____ R _____

S _____ T _____ R _____

S _____ T _____ R _____

A12

M12

2. Property Controlling
in Section

3. Miscellaneous

Property in Section

4. Lot No. _____, Recorded Plat _____

5. Private Claims _____

I, Robert L. Jamros, in a field survey on June 12, 1995, 19_____,
do hereby certify that under requirements of P.A. 74, Michigan P.A. of 1970, the corner points mentioned
in lines 1 and 2 above were in conformance with regulations and rules therefore as required in the current
manual of survey instructions of the United States Department of the Interior, Bureau of Land
Management or by a decree of a Court of Law and/or that the corner points mentioned in lines 3, 4 and
5 above were in conformance with the rules of the Michigan Board of Professional Surveyors or by a
Decree of a Court of Law; established, re-established, monumented, re-monumented, recovered, found
as expressed below:

**NOTE: Not more than 4 corners, all in the same town and range, may be recorded
on this certificate.**

A. Description of original monument and accessories and/or subsequent restoration:

A12: PLS-William A. Burt, DS, 1841, Set Gr. Section Post- Maple 8', S.28 W., 28 links, Maple 13', N.60 E., 29 links. Alger County Road
Commission, Edwin Swan, RLS, 1938 Alignment notes for Coaster Road. Corner position noted by road stationing only. Larry J. Bussone,
RLS, 1989, Set 1/2" iron w/cap at mid-point between NE and SE section corners. Established the following references. C/L road, East,
1.0, Spruce 3', S.69 E., 23.1', P.Pole, S.23 W., 94.7', C/L Power line, West, 31.2'.

B. Description of corner evidence found and/or method applied in restoring or reestablishing corner:

A12: Found 1/2" x 18" rebar with cap missing 1.0 feet west of centerline of road and two inches deep. Corner position was reestablished
by single proportionate measurement as stated in report by Larry Bussone, RLS, 1989. A search was made at GLO bearing tree locations,
no evidence found. Installed new monument and established new references. Corner position is accepted as a careful and faithful
reestablishment of the position of the original corner.


C. Description of monument for corner and accessories established to perpetuate locating the position of the corner:

A12: Replaced existing 1/2" rebar w/ 5/8" x 18" rebar w/ Berntsen Cap no. RBD5325 stamped to identify corner position. Established the
following reference trees w/ BT signs, blazed, scribed and painted. Set PK nails for measure w/ Alum. I.D. washers in the following
reference trees. Maple 7', S.67 W., 60.16 feet, " 1/4s BT ", Maple 7', N.43 W., 81.26 feet, " 1/4s BT ", Maple 6', N.58 E., 71.40 feet,
" 1/4s BT ", Cherry 8', S.51 E., 51.77 feet, " 1/4s BT ". All bearings are magnetic.

Signed by

Surveyor's Michigan License No.

25849

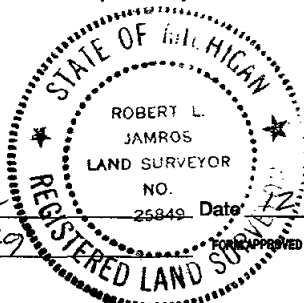

12 December 1995

FORM APPROVED BY MICHIGAN STATE BOARD OF PROFESSIONAL SURVEYORS, JAN. 23, 1971
REVISED MAY 14, 1975
REVISED JAN., 1983