

SURVEY & REMONUMENTATION

FEB 23 1999

Approved by Alger County
Land Survey Remonumentation
Peer Group Under Act 345 of
P.A. of 1990 On 12/16/1998

SECTION

LAND CORNER RECORDATION CERTIFICATE Filing Requirement of Act 74, Mich. P.A. 1970

05-129

For corners in

<u>Alger</u> (County)	Located In:	Corner Code #
1. Public Land Survey	T46N R17W	<u>D 13</u> ✓
	T45N R17W	<u>D 1</u>
	T R	
	T R	
2. Property Controlling in Section	S T R	
	S T R	
3. Miscellaneous	S T R	
Property in Sec.	S T R	
4. Lot No. _____, Recorded Plat _____		
5. Private Claims _____		

TIME 10:00 AM

JAN 8 1999

DONALD W. KINNUNEN
REGISTER OF DEEDS
ALGER COUNTY, MI

Register of Deeds Stamp & File Number

I, Robert L. Jamros, in a field survey on November 25, 1998 do hereby state that under requirements of P.A. 74, Michigan P.A. of 1970, the corner points mentioned in lines 1 and 2 above were in conformance with regulations and rules therefore as required in the current manual of survey instructions of the United States Department of the Interior, Bureau of Land Management or by a decree of a Court of Law and/or that the corner points mentioned in lines 3, 4 and 5 above were in conformance with the rules of the Michigan Board of Land Surveyors or by a Decree of a Court of Law, established, re-established, monumented, recovered, found as expressed below:

NOTE: Not more than 2 corners, all in the same town and range, may be recorded on this certificate.

A. Description of original monument and accessories and/or subsequent restoration:

D13: P.L.S. - William A. Burt, DS, 1841. * Set quarter section post. Hemlock 20" N. 85°E., 59 links. * Birch 10", N.55° W. 17 links. ***** Billy D. Buckler, RLS, 1957. * Reestablished quarter corner midway and on line between 2 sections corners. No evidence of original corner. Corner placed and reestablished January 4, 1957. * Set 1" iron pipe with 4" brass cap. * Witness, Aspen 9", N.87°W., 62 links, marked "1/4S NBT". Recorded in Liber 2, Page 182, Alger County Records. ***** No other record of restoration.

B. Description of corner evidence found and/or method applied in restoring or reestablishing corner:


D13: Found 1" iron pipe with brass cap, stamped to identify corner position. Located corner position by standard field survey and single proportionate measurement, monument in an acceptable location. Michigan Department of Conservation, Forestry Division Monument. * Search was made for NBT and guard post, no evidence found. Corner lies in open marsh 70 feet more or less West of the centerline of abandoned railroad grade. * Established new reference trees. Monument as found at corner position is accepted as a careful and faithful reestablishment of the position of the original corner.

C. Description of monument for corner and accessories established to perpetuate locating the position of the corner:

D13: Stamped P.A. 345 in existing brass capped monument. Established reference trees with BT signs, scribed and painted. * Set PK nails with aluminum I.D. washers for measure in the following reference trees. * Balsam 6", N.26°W., 28.35 feet, no blazes, scribed "BT"; * Spruce 8", N.12°E., 51.18 feet, no blazes, scribed "BT"; * Spruce 3", S.38°W., 14.91 feet, no blazes, scribed "BT"; * Balsam 8", S.88°E., 85.97 feet, blazed and scribed "1/4S BT". * Survey marker sign on 6 foot steel post, S.70°W., 1.3 feet. * All bearings are magnetic.

Signed by Robert L. Jamros
Surveyor's Michigan License No. 25849

Date December 16, 1998

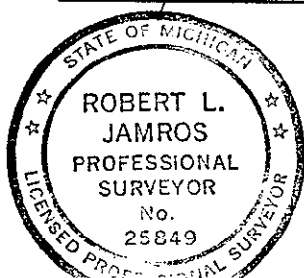

FORM APPROVED BY MICHIGAN STATE BOARD OF PROFESSIONAL SURVEYORS, JAN. 28, 1971
REVISED MAY 14, 1976
REVISED JAN. 1983
REVISED OCT. 1996