

LAND CORNER RECORDATION CERTIFICATE
Filing Requirement of Act 74, Mich. P.A. 1970 as Amended

For corners in

Alger

(County)

Located In:

Corner Code #

1. Public Land Survey

T R
T R
T R

2. Property Controlling
in Section

S 22 T 47N R 17W
S 22 T 47N R 17W
S T R

8
15

3. Miscellaneous
Property in Sec.

S T R
S T R

4. Lot No. , Recorded Plat

5. Private Claims

8 05/09/2012

I, Stephan J. Szyszkoski, in a field survey on

15 05/09/2012

do hereby state

that under requirements of P.A. 74, Michigan P.A. of 1970, the corner points mentioned in lines 1 and 2 above were in conformance with regulations and rules therefore as required in the current manual of survey instructions of the United States Department of the Interior, Bureau of Land Management or by a decree of a Court of Law and /or that the corner points mentioned in lines 3, 4 and 5 above were in conformance with the rules of the Michigan Board of Land Surveyors or by a Decree of a Court of Law; established, re-established, monumented, recovered, found as expressed below:

NOTE: Not more than 2 corners, all in the same town and range, may be recorded on this certificate.

A. Description of original monument and accessories and/or subsequent restoration:

(8-Sec. 22) West 1/16 corner, Section 22. Not previously monumented.

(15-Sec. 22) West 1/16 corner between Sections 22 and 27. Not previously monumented.

B. Description of corner evidence found and/or method applied in restoring or reestablishing corner:

(8-Sec. 22) Established the position for the corner midway and on a straight line between Quarter corner 1319.94' west and the intersection of 1/4 lines of Section 22 1319.94' east.

(15-Sec. 22) Established the position for the corner midway and on the Section line between Section corner 1320.41' west and Quarter corner 1320.41' east.

C. Description of monument for corner and accessories established to perpetuate locating the position of the corner:

(8) Set 1"IDx36" I.pipe with 4" alum. MDNR cap.
Set measuring nail with MDNR tag in the side of:
7" Cedar S15E 8.0' mrkd "W1/16 BT"
8" Cedar S67W 26.8' do
10" W.Birch N07W 26.9' do
6" Maple N49E 20.35' do
Bearings are magnetic.

(15) Set 1"IDx36" I.pipe with 4" alum. MDNR cap.
Set measuring nail with MDNR tag in the side of:
11" Sugar S29W 19.6' mrkd "W1/16 BT"
11" Sugar S06E 18.0' do
18" Maple S73E 42.6' do
6" Y.Birch N23E 48.3' do
Bearings are magnetic.

Register of Deeds Stamp & File Number

	A	B	C	D	E	F	G	H	I	J	K	L	M
1													
2	6		5		4		3		2		1		
3													
4	7		8		9		10		11		12		
5													
6	18		17		16		15		14		13		
7													
8	19		20		21		22		23		24		
9													
10	30		29		28		27		26		25		
11													
12	31		32		33		34		35		36		
13													

Signed by

Stephan J. Szyszkoski


Date

07/26/2012

Surveyor's Michigan License No.

33986

For the Michigan Department of Natural Resources, Forest Resources Division

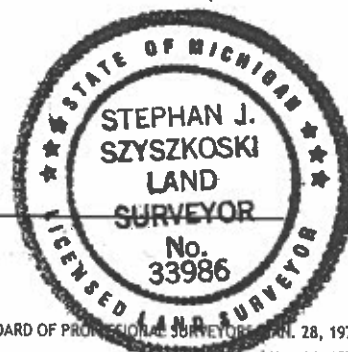

47534

47535

FORM APPROVED BY MICHIGAN STATE BOARD OF PROFESSIONAL SURVEYORS JAN. 28, 1971

Revised May 14, 1975

Revised Jan., 1983

Revised Oct., 1995