

SURVEY & REMONUMENTATION

FEB 23 1999

Approved by Alger County
Land Survey Remonumentation
Peer Group Under Act 345 of
P.A. of 1990 On 12/16 1998

SECTION

LAND CORNER RECORDATION CERTIFICATE Filing Requirement of Act 74, Mich. P.A. 1970

05-124

Chairman
For corners in

Alger
(County)

Located In:

Corner Code #

1. Public Land Survey

T48N R15W

H 5

2. Property Controlling
in Section

S

T

R

R

R

3. Miscellaneous
Property in Sec.

S

T

R

R

R

4. Lot No. _____, Recorded Plat _____

5. Private Claims _____

TIME 10:00 A.M.

JAN 8 1999

DONALD W. KINNUNEN
REGISTER OF DEEDS
ALGER COUNTY, MI

Register of Deeds Stamp & File Number

I, Robert L. Jamros, in a field survey on September 16, 1998 do hereby state that under requirements of P.A. 74, Michigan P.A. of 1970, the corner points mentioned in lines 1 and 2 above were in conformance with regulations and rules therefore as required in the current manual of survey instructions of the United States Department of the Interior, Bureau of Land Management or by a decree of a Court of Law and for that the corner points mentioned in lines 3, 4 and 5 above were in conformance with the rules of the Michigan Board of Land Surveyors or by a Decree of a Court of Law, established, re-established, monumented, recovered, found as expressed below:

NOTE: Not more than 2 corners, all in the same town and range, may be recorded on this certificate.

A. Description of original monument and accessories and/or subsequent restoration:

H5: P.L.S. - George E. Adair, DS, 1851. Set quarter section post. W. Pine 26, N.35°W., 52 links. W. Pine 42, S.40°E., 54 links. ***** Dean C. DeLamater, RLS, 1951. This corner was established by proportionate measurement. 2 probable BT'S in place, badly burned. Set 1" G.I.P. with brass cap. Witnesses, 45" W. Pine stump, S.81°E., 16 links. * 28" W. Pine stump, S.30°W., 85 links. * Liber 2, page 8, Alger County Corner Records. ***** No other record of restoration.

B. Description of corner evidence found and/or method applied in restoring or reestablishing corner:

H5: Located corner position by standard field survey and single proportionate measurement. Found monument and accessories of the 1951 report in good condition and at an acceptable location. Established additional reference trees. Monument as found is accepted as a careful and faithful reestablishment of the position of the original corner.

C. Description of monument for corner and accessories established to perpetuate locating the position of the corner:


H5: Existing 1" G.I.P. with brass cap. * Renewed existing references with BT signs. * Established 2 new reference trees with BT signs, blazed, scribed and painted. * Set PK nails for measure with aluminum I.D. washers in the following, Red Pine 4", N.29°W., 46.82 feet, "BT"; * Red Pine 4", N.86°W., 37.04 feet, "BT"; * Existing - White Pine stump 45", S.73°E., 10.33 feet; * Existing - White Pine stump 28", S.37°W., 55.96 feet. * Survey marker sign on 6 foot steel post, N.51°E., 1.0 feet. * All bearings are magnetic.

Signed by

Surveyor's Michigan License No.

25849

Date December 16, 1998

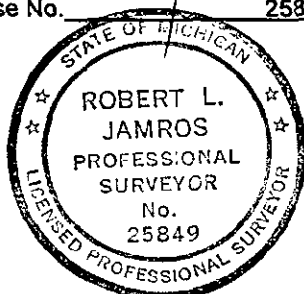

FORM APPROVED BY MICHIGAN STATE BOARD OF PROFESSIONAL SURVEYORS, JAN. 28, 19
REVISED MAY 14, 11
REVISED JAN. 11
REVISED OCT. 11