

REMONUMENTATION

APR 25 1995

COMMISSION

For corners in

ALLEGAN
(County)

Located In:

Corner Code ##

1. Public Land Survey

T 1N R 14W

A-1 Cheshire

T 1N R 15W

M-1 Lee

T 2N R 14W

A-13 Valley

T 2N R 15W

M-13 Clyde

2. Property Controlling
in Section

S T R

S T R

3. Miscellaneous
Property in Sec.

S T R

S T R

4. Lot No. , Recorded Plat

5. Private Claims

I, Donald R. Pitts Jr., in a field survey on August 8, 19 94, do hereby certify that under requirements of P.A. 74, Michigan P.A. of 1970, the corner points mentioned in lines 1 and 2 above were in conformance with regulations and rules therofore as required in the current manual of survey instructions of the United States Department of the Interior, Bureau of Land Management or by a decree of a Court of Law and/or that the corner points mentioned in lines 3, 4 and 5 above were in conformance with the rules of the Michigan Board of Land Surveyors or by a Decree of a Court of Law; established, re-established, monumented, re-monumented, recovered, found as expressed below:

NOTE: Not more than 4 corners, all in the same town and range, may be recorded on this certificate.

A. Description of original monument and accessories and/or subsequent restoration:

G.L.O.-Intersect range line 380 Links N. of temporary post. Set post corner
Towns 1N. & 2N. Ranges 14 & 15 W.
W. Oak 12" N.30°W. 39 Links
Pine 16" S.18°W. 13 Links
1897-Allegan Co. Surveyor Notes
Stake & Brick
10" Oak N.W. 35.02'
13" Oak S.W. 30.2'

APPROVED REMONUMENTATION CORNER
P.A. 345 OF 1990
ALLEGAN COUNTY
DATE APPROVED 4-12-94
COUNTY REP. Paul A. VanHouten


(CONTINUED ON BACK OF CERTIFICATE)

B. Description of corner evidence found and/or method applied in restoring or reestablishing corner:

Found 1" Iron
Nail & D.N.R. Tag S. Side Power Pole N.W. 59.01'
" " " " E. Side 18" Oak S. 34.40'
" " " " N.W. Side Twin 12" Oak S.W. 41.96'
Pulled Iron and set standard Allegan Co. Remon. 3/4" X 24" Iron with red cap #23520
Traversed 4954' East
Approved by the Allegan Co. Remon. Peer Group on April 12, 1994, and is accepted as a careful and faithful perpetuation of the position of the original corner

C. Description of monument for corner and accessories established to perpetuate locating the position of the corner:

Standard Allegan Co. Remon. 3/4" X 24" Iron with red cap #23520
Nail & Allegan Co. Remon Tag E. Side 18" Oak S.34.42'
" " " " " S.W. Side Power Pole N.50°W. 58.95'
" " " " " N.E. Side 12" Oak S.35°E. 31.09'
" " " " " N.E. Side Twin 12" Oak S.60°W. 41.89'

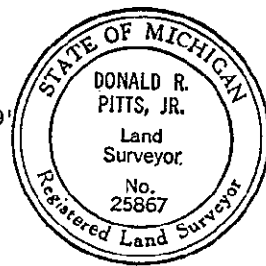

Signed by

Donald R. Pitts Jr.

Date August 30, 1994

Surveyor's Michigan License No. 25867

USER 0005 PAGE 045


Sheet 1 of 2

FORM APPROVED BY MICHIGAN STATE BOARD OF LAND SURVEYORS, JAN. 28, 1971
REVISED MAY 14, 1975
REVISED JAN., 1983

1994 DEC 16 AM 9:56
REGISTER OF DEEDS
ALLEGAN COUNTY, MICHIGAN
James A. Chatter

FILED

Register of Deeds Stamp & File Number

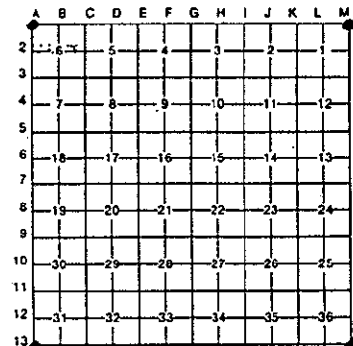

(CONTINUED FROM FRONT OF CERTIFICATE)

A. DESCRIPTION OF ORIGINAL MONUMENT AND ACCESSORIES AND/OR SUBSEQUENT RESTORATION.

1963-Allegan Co. Surveyor Notes

N.W. Cor. Found old stakes & brick, set 1" Iron in Stake	
25" Oak	N.W. 96.5'
Power Pole	N.W. 58.7'
25" Oak	W.N.W. 35.0'
5" Twin Oak	S.W. 42.0'
10" Oak	S.5°W. 57.55'
10" Oak	S. 34.0'
10" W. Cherry	S.S.E. 27.5'
St. Sign	S.S.E. 20.94'
12" & 8" T.W. Oak	S.E. 57.3'

1992-Kirk L. Van Order, Allegan Co. Surveyor

Nail & D.N.R. Tag in N.W. side Twin 12" Oak	S.W. 41.96'
" " " " in S. side P. Pole	N.W. 59.01'
Nail in top of wood post	S.,S.W. 37.37'
Nail in E. Side 18" W. Oak	S. 34.40'