

RF

MAR 07 2000

**ALLEGAN COUNTY REMONUMENTATION
LAND CORNER RECORDATION CERTIFICATE**
Filing Requirement of Act 74, Mich. P.A. 1970

FILED

00 FEB -1 AM 8:36

For corners in **SECTION****Allegan**
(County)Located In: **Cheshire**
(Township)Corner Code **#J-11**

- | | | |
|-------------------------|---|-------------------------------|
| 1. Public Land Survey | <u>T 1N R 14W</u> | <u>N1/4 COR SEC 35</u> |
| | T <u> </u> R <u> </u> | <u> </u> |
| | T <u> </u> R <u> </u> | <u> </u> |
| | T <u> </u> R <u> </u> | <u> </u> |
| 2. Property Controlling | S <u> </u> T <u> </u> R <u> </u> | <u> </u> |
| in Section | S <u> </u> T <u> </u> R <u> </u> | <u> </u> |
| 3. Miscellaneous | S <u> </u> T <u> </u> R <u> </u> | <u> </u> |
| Property in Sec. | S <u> </u> T <u> </u> R <u> </u> | <u> </u> |

Joyce M. Smith
REGISTER OF DEEDS
ALLEGAN COUNTY, MICH.

Register of Deeds Stamp & File Number

4. Lot No. , Recorded Plat
5. Private Claims -

I, Robert E. Lemke, surveyor, in a field survey on March 13, 1998 do hereby state that under requirements of P.A. 74, Michigan P.A. of 1970, the corner points mentioned in lines 1 and 2 above were in conformance with regulations and rules therefore as required in the current manual of survey instructions of the United States Department of the Interior, Bureau of Land Management or by a decree of a Court of Law and /or that the corner points mentioned in lines 3, 4 and 5 above were in conformance with the rules of the Michigan Board of Land Surveyors or by a Decree of a Court of Law; established, re-established, monumented, recovered, found as expressed below:

	A	B	C	D	E	F	G	H	I	J	K	L	M
1													
2	6			5		4			3		2		1
3													
4	7			8		9			10		11		12
5													
6	18			17		16			15		14		13
7													
8	19			20		21			22		23		24
9													
10	30			29		28			27		26		25
11													
12	31			32		33			34		35		36
13													

NOTE: Not more than 2 corners, all in the same town and range, may be recorded on this certificate.

A. Description of original monument and accessories and/or subsequent restoration:

J -11 GLO**County Surveyor Sketch****L.C.R.C. L02-P08**

West correct line
Between Sec.s 26 & 35
41.00 set 1.4 Sec. post
Beech 30" S. 40 E. 11 links
Sugar 18" N. 13 E. 36 links

February 16, 1880
"Stone"
Shows stone on line and in
between I-11 and K-11
I-11 to J-11 40.98 c. = 2704.68
J-11 to K-11 40.78 c. = 2691.48

Found 1/2" iron bar in patch in paving
Found Nail w/ribbon in t/guard post SW 60.30'
Set Nail in top of end guard post SE 46.65'
Angle iron fence post NW 52.60'
9/20/72 D. A. Middleton, P.S. #16049
CONTINUED ON SHEET 2

B. Description of corner evidence found and/or method applied in restoring or reestablishing corner:

J-11


Per L.C.R.C. L02-P08 - Found 1/2" bar in monument box
Nail w/ribbon in t/guard post SW 60.30'
Nail in t/guard post SE 46.65'
Angle iron fence post NW 52.60' (not found)
Measured distance from J-11 to K-11 2698.18'
Measured distance from I-11 to J-11 2712.26'

And is accepted as a careful and faithful **perpetuation** of the position of the original corner.

C. Description of monument for corner and accessories established to perpetuate locating the position of the corner:

J-11

Set standard Allegan County monument (3/4" x 24" steel rod w/red cap #23520), 0.6 ft. below bituminous paving surface in monument box at intersection of pavement centerlines, 102nd Avenue and 39th Street:
Nail w/tag, top of wood guard post, 0.3 ft. N of tel. pedestal #1601/1 - N 55° W, 62.75 ft.
Nail w/tag, SE side, wood guard post, 1.0 ft. above grade - N 60° E, 46.65 ft.
Nail w/tag, top of East most Guard Post - S 45° E, 46.65 ft.
Nail w/tag, top of West most Guard Post - S 75° W, 60.30 ft.

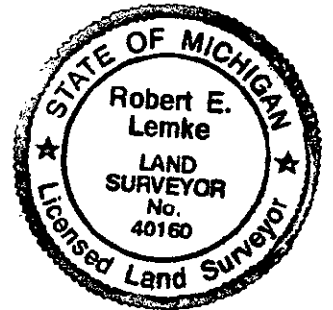

APPROVED REMONUMENTATION CORNER
P.A.345 OF 1990
ALLEGAN COUNTY
DATE APPROVED APRIL 14, 1998
COUNTY REP. Robert E. Lemke

Signed by Robert E. Lemke

For SDI CONSULTANTS, LTD

Surveyor's Michigan License No. 40160Date 4/13/1998

MAR 07 2000

J-11 Part "A" Continued

SECTION

Act 132 Survey (not recorded)

Wightman-Moored, Inc. 10/15/87

No witnesses

Shows measured distance between J-11 and K-11 = 2698.97 ft.

Act 132 Survey

L1388-P517

Wightman-Moored, Inc. 12/09/92

S ¼ Post Sec 26 T1N-R14W

-fd. ¾" iron in mon. box

-nail in top end guard post SW 60.30'

-fe. Post NW 52.80 to CL

-nail in top end guard post SE 48.65'

-P.O.T. iron (on S. sec. Line) West 491.75'

Act 132 Survey (not recorded)

K.L. VanOrder, P.S. 07/24/97

found ½" iron bar

nail top of guard post SW. 60.30'

nail top of end guard post SW. 46.65'

CL angle iron post NW. 52.60'

Witness Card

Middleton

Nail in top of end guard post SW. 60.30'

Nail in top of end G. post SE. 46.65'

angle iron f. post NW. 52.60' to cl

I-11 to J-11 2713.90'

J-11 to K-11 2698.97'