

ALLEGAN COUNTY REMONUMENTATION
LAND CORNER RECORDATION CERTIFICATE
Filing Requirement of Act 74, Mich. P.A. 1970

For corners in

Allegan
(County)

Located In: Cheshire Corner Code #I-11/12(Seq#5)
(Township)

1. Public Land Survey T 1N R 14W
T _____ R _____
T _____ R _____
T _____ R _____
2. Property Controlling S 35 T 1N R 14W
in Section S _____ T _____ R _____
3. Miscellaneous S _____ T _____ R _____
Property in Sec. S _____ T _____ R _____
4. Lot No. _____, Recorded Plat _____
5. Private Claims _____

FILED

1/28/1999 2:44:39 PM

JOYCE A. WATTS
REGISTER OF DEEDS
ALLEGAN COUNTY, MICH

Register of Deeds Stamp & File
Number

LIBER0006 PAGE345

I, Robert E. Lemke, surveyor, in a field survey on April 20, ¹⁹⁹⁸~~1997~~ do hereby state that under requirements of P.A. 74, Michigan P.A. of 1970, the corner points mentioned in lines 1 and 2 above were in conformance with regulations and rules therefore as required in the current manual of survey instructions of the United States Department of the Interior, Bureau of Land Management or by a decree of a Court of Law and/or that the corner points mentioned in lines 3, 4 and 5 above were in conformance with the rules of the Michigan Board of Land Surveyors or by a Decree of a Court of Law; established, re-established, monumented, recovered, found as expressed below:

NOTE: Not more than 2 corners, all in the same town and range, may be recorded on this certificate.

	A	B	C	D	E	F	G	H	I	J	K	L	M
1													
2	6			5			4		3		2		1
3													
4	7			8			9		10		11		12
5													
6	18			17			16		15		14		13
7													
8	19			20			21		22		23		24
9													
10	30			29			28		27		26		25
11													
12	31			32			33		34		35		36
13													

A. Description of original monument and accessories and/or subsequent restoration:

Corner not set by G.L.O., this is an Allegan County witness monument.

(See back of sheet)

B. Description of corner evidence found and/or method applied in restoring or reestablishing corner:

(See back of sheet)

C. Description of monument for corner and accessories established to perpetuate locating the position of the corner:

Set standard Allegan County monument (3/4" x 24" steel rod w/red cap #23520)

Sequence Corner #5 (see map on back)

Nail w/tag in East side of 8" Ash, 1.2' above grade, N14°E 24.86'

Nail w/tag in West side of 36" Cotton, 0.4' above grade, N39°E, 50.79

Nail w/tag in SW side of 20" Maple 0.7', above grade, S75°E, 9.91"

Nail w/tag in NE side of 10" Ash, 1.6" above grade, N56°W, 28.50'

Edge of water "Little Eagle Lake", S9°W, 8.10'

South end of wire fence, N9°E, 8.30'

Sequence corner is on West line of Section 35, T.1N., R.14W., 3124.44' Northerly from I-13

APPROVED REMONUMENTATION CORNER

P.A. 345 OF 1990

ALLEGAN COUNTY

DATE APPROVED JUNE 9, 1998

COUNTY REP. Robert E. Lemke

Signed by


Robert E. Lemke

Date

6/9/98

For: SDI CONSULTANTS, LTD.

Surveyor's Michigan License No. 40160

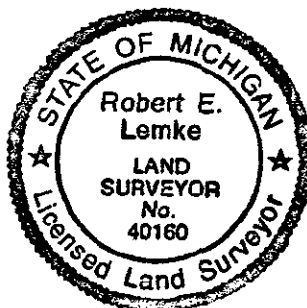

Sheet 1 of 2

E:\1998\H98013\corn\AllegCoRemon\ChesT1NR14W\I-12-1
FORM APPROVED BY MICHIGAN STATE BOARD OF PROFESSIONAL SURVEYORS
JAN. 28, 1971 REVISED MAY 14, 1975
REVISED JAN., 1983
REVISED OCT., 1995

- A. I-12 GLO
April, 1831 Calvin Britain, D.S.
"Quarter section cor. in lake"

B. No evidence of corner was found. 1880 notes by Gardner state that I-12 was on a straight line between I-11 & I-13. The position of I-12 is calculated to be on a straight line between I-11 & I-13. The distance of 2629.61 from I-11 to I-12 as shown on the survey card was held. This position not established by original government surveyors. This calculated position is accepted as the best available evidence of the position of the corner.

County Surveyor Notes
Feb. 16, 1880
"At W 1/4 fd. cor. by stakes set by Hicks in survey
Sec. 34, A. Gardner, Co. Sur.

Survey Card
Shows I-12 on line & between I-11 and I-13,
2629.61 from I-11 to I-12
2629.61 from I-12 to I-13

I 11-12 (SEQ.#5)
CHESHIRE TWP.

