

ALLEGAN COUNTY REMONUMENTATION  
LAND CORNER RECORDATION CERTIFICATE  
Filing Requirement of Act 74, Mich. P.A. 1970

For corners in

Allegan  
(County)

Located in: Cheshire  
(Township)

Corner Code: #1-12/13(Seq.#6)

1/28/1999 2:44:39 PM

JOYCE A. WATTS  
REGISTER OF DEEDS  
ALLEGAN COUNTY, MICH

1. Public Land Survey

T 1N R 14W

T R

T R

T R

2. Property Controlling  
in Section

S 35 T 1N R 14W

S T R

3. Miscellaneous  
Property in Sec.

S T R

S T R

Register of Deeds Stamp & File  
Number

4. Lot No. , Recorded Plat

5. Private Claims

1998

I, Robert E. Lemke, surveyor, in a field survey on April 20, 1998 do hereby state that under requirements of P.A. 74, Michigan P.A. of 1970, the corner points mentioned in lines 1 and 2 above were in conformance with regulations and rules therefore as required in the current manual of survey instructions of the United States Department of the Interior, Bureau of Land Management or by a decree of a Court of Law and /or that the corner points mentioned in lines 3, 4 and 5 above were in conformance with the rules of the Michigan Board of Land Surveyors or by a Decree of a Court of Law; established, re-established, monumented, recovered, found as expressed below:

NOTE: Not more than 2 corners, all in the same town and range, may be recorded on this certificate.

	A	B	C	D	E	F	G	H	I	J	K	L	M
1													
2	6		5		4		3		2		1		
3													
4	7		8		9		10		11		12		
5													
6	18		17		16		15		14		13		
7													
8	19		20		21		22		23		24		
9													
10	30		29		28		27		26		25		
11													
12	31		32		33		34		35		36		
13													

A. Description of original monument and accessories and/or subsequent restoration:

Corner not set by G.L.O. ,this is an Allegan county witness monument.

(See back of sheet)

B. Description of corner evidence found and/or method applied in restoring or reestablishing corner:

(See back of sheet)

FILED

1/28/1999 2:44:39 PM

JOYCE A. WATTS  
REGISTER OF DEEDS  
ALLEGAN COUNTY, MICH

C. Description of monument for corner and accessories established to perpetuate locating the position of the corner:

Set standard Allegan County monument ( 3/4" x 24" steel rod w/red cap #23520)

Sequence Corner #6 ( See Map on back).

Nail w/tag in N. side of 14" Ash, 1.6' above grade, N45°E, 15.42'

Nail w/tag in E. side of 12" Ash, 1.4' above grade, S38°E, 14.89'

Nail w/tag in SE. side of 22" Maple, 1.1' above grade, S35°W, 37.90'

Nail w/tag in S, side of 18" Ash, 1.8' above grade, S78°W, 21.75'

Edge of water "Little Eagle Lake", N0°E, 64.5'

Edge of water "Little Eagle Lake marsh", N90°E, 32.0'

Sequence corner is on West line of Section 35, T.1N.,R.14W.

Sequence corner is 2462.47' Northerly from I-13

APPROVED REMONUMENTATION CORNER  
P.A. 345 OF 1990  
ALLEGAN COUNTY

DATE APPROVED JUNE 9, 1998  
COUNTY REP. [Signature]

Signed by


Robert E. Lemke

Date

6/9/98

For: SDI CONSULTANTS, INC.

Surveyor's Michigan License No. 40160

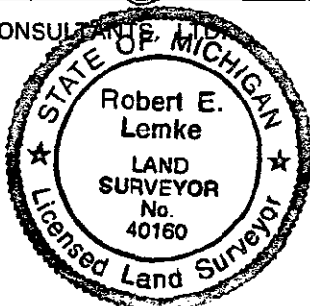

Sheet 1 of 2

E:\1998\H98013\com\AlegCoRemon\ChesT1NR14W\12-1  
FORM APPROVED BY MICHIGAN STATE BOARD OF PROFESSIONAL SURVEYORS  
JAN. 28, 1971 REVISED MAY 14, 1975  
REVISED JAN., 1983  
REVISED OCT., 1995

- A. I-12 GLO  
April, 1831 Calvin Britain, D.S.  
"Quarter section cor. in lake"

B. No evidence of corner was found. 1880 notes by Gardner state that I-12 was on a straight line between I-11 & I-13. The position of I-12 is calculated to be on a straight line between I-11 & I-13. The distance of 2629.61 from I-11 to I-12 as shown on the survey card was held. This position not established by original government surveyors. This calculated position is accepted as the best available evidence of the

County Surveyor Notes  
Feb. 16, 1880  
"At W 1/4 fd. cor. by stakes set by Hicks in survey  
Sec. 34, A. Gardner, Co. Sur.

Survey Card  
Shows I-12 on line & between I-11 and I-13,  
2629.61 from I-11 to I-12  
2629.61 from I-12 to I-13

position of the corner.

I 12-13 (Seq.#6)  
CHESHIRE TWP.

