

SURVEY
REMONUMENTATION

APR 29 1999

Allegan County Remonumentation

SECTION

LAND CORNER RECORDATION CERTIFICATE
Filing Requirement of Act 74, Mich. P.A. 1970

For corners in

Allegan

(County)

Located in:

Corner Code #

1. Public Land Survey

T 2N R 11W F-1 (N1/4 4) Martin Twp.

2. Property Controlling
in Section

S

T R

3. Miscellaneous
Property in Sec.

S

T R

4. Lot No. , Recorded Plat

5. Private Claims

FILED

1/28/1999 2:44:39 PM

JOYCE A. WATTS
REGISTER OF DEEDS
ALLEGAN COUNTY, MICH

Register of Deeds Stamp & File Number

I, Steven Koerber, in a field survey on Oct 6, 19 98 do hereby state that under requirements of P.A. 74, Michigan P.A. of 1970, the corner points mentioned in lines 1 and 2 above were in conformance with regulations and rules therefore as required in the current manual of survey instructions of the United States Department of the Interior, Bureau of Land Management or by a decree of a Court of Law and/or that the corner points mentioned in lines 3, 4 and 5 above were in conformance with the rules of the Michigan Board of Land Surveyors or by a Decree of a Court of Law; established, re-established, monumented, recovered, found as expressed below:

NOTE: Not more than 2 corners, all in the same town and range, may be recorded on this certificate.

A. Description of original monument and accessories and/or subsequent restoration:

F-1 Corner not set by GLO

1. Old notes

(Additional info. on back)

Stone

18" Elm NE 85'

12" Maple SE 49.7'

B. Description of corner evidence found and/or method applied in restoring or reestablishing corner:

F-1 Found 1" Iron rod in Mon. box
Nail in P. Pole North 31.92'
NW corner headwall S10°W 72.40'

APPROVED REMONUMENTATION CORNER
P.A. 345 OF 1990
ALLEGAN COUNTY

DATE APPROVED Oct 13, 1998
COUNTY REP. [Signature]


This position not established by original government surveyors. This monument is accepted as the best available evidence of the position of the corner.
Peer Group approval October 13, 1998.
Dist to G-1 = 2664.97'

C. Description of monument for corner and accessories established to perpetuate locating the position of the corner:

F-1 Set Standard Allegan Co. Mon. (3/4" x 24" Iron Rod with Remon.cap)
Set nail & Allegan Co. Remon. tag in N. side 42" Maple S50°E 69.98'
Set nail & Allegan Co. Remon. tag in E. side P.Pole North 32.12'
Set nail & Allegan Co. Remon. tag in S. side 10" stem of tri-Poplar clump S70°W 78.43'
NE edge of RR rail on end N35°W 47.31'
F-13 S 1/4 corner Sec. 33-3-11 Wayland Twp. West 79.18'

Signed by [Signature]
Surveyor's Michigan License No. 39085

Date 12-15-1998

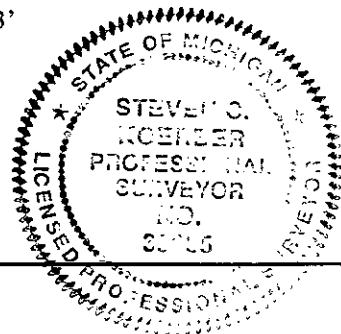

SURVEY
REMONUMENTATION

APR 29 1968

SECTION

Page 2 of 2

F-1 MARTIN TWP.

2. Witness card 7-27-1968
Fnd. stake and stone with 'x'
Raised with 1/2" solid iron
P. Pole North 31.6'
Rail corner post NW 47.0'
Street sign WSW 70.4'
41" Maple SE 58.9'

3. L.C.R.C. Liber 2, Page 127 October, 1973
Donald Ratekin
Couldn't locate corner. Reset by using remaining witnesses in No. 2 above
Nail in P. Pole North 31.92'
NW corner headwall S10°W 72.40'
Street sign S55°W 70.4'

LIBERO 006 PAGE 92