
APR 07 1998					
- -		MONUMENTATION	, 0	S 8	
_	LAND CORNER RECO	RDATION CERTIFICAT Act 74, Mich. P.A. 1970		£	
For corners in Allegen Hounty	· ····· · · · · · · · · · · · · · · ·		SYS I	}	=
			CGUP	22	1
ALLEGAN Located in	: Corner Code	#	<u> 26</u>	E 13	П
-	D / FP 13	W	#\ ₹%	FH 1: 17	
•		Monterey Twp		6 =	
		CLASCAN TWP.			٠
2. Property Controlling S-33 T-3N	R-13W Monters	# 1)) v TWP			
in Section S-4 T-2N 3. Miscellaneous S T	R-13W Allegan	Twp			
	R		Register of Dec	eds Stamp & File	Number
		<u> </u>	v		
Lot No, Recorded Plat Private Claims		****	•		
5. Frivate Claims		·	ABCDE	FGHI	J K L H
A ADMINIST DESCRIPTION		2	┝┋═┼╌┋╼┼		┆ ─┼─┆╌┤
requirements of P.A. 74, Michigan P.A. of 1970, the	corner points mentioned in lines 1	and 2 above were in			
conformance with regulations and rules therefore as re United States Department of the Interior, Bureau of Land	d Management or by a decree of a C	curt of Law and/or that		- 9	
the corner points mentioned in lines 3, 4 and 5 above w Land Surveyors or by a Decree of a Court of Law; esta	ere in conformance with the rules of blished, re-established, monumente	IND MICHIGAN BORRO OF	-18-12-	-1615	
expressed below:		7			
NOTE: Not more than 2 corners, all in the san on this certificate.	te town and range, may be reco	orded 8	-19	_21222	2324
		9		- - - -	 -
A Deposite of estated and and a second		10	3029	-2B27:	2625
A. Description of original monument and	accessories and/or subsequ				
EF-13 (SEQ. NO. 3)/EF-1 (Se	EQ. NO.1)	. 12			
WEST SIDE SECTION-33, T-3N, F		OCT. 31, 1997	•	•	
-40.00 SET QUARTER SECTION I BORDER OF LAKE	SOSTON	D.R. PITS, JR., P.S. -SET CONC. MON, W/CA	4 P 643 86' WES	T OF F-13	
-80.00 COR. SECTIONS 32 & 33 11	N LAKE	(T-3N, R-13W) ON LINI	E BETWEEN F	13 AND -	
MEANDER TRAVERSE OF LAKE	REGINS	SEQ NO. 1 (L-0005, PG-	-101) ON W. SI	DE DUMONT L	AKE
AT \$1/4 (F-13) IN G.L.O. NOTE					
B. Description of corner evidence foun	d and/or method applied i				
		n restoring or reestablish	ng corner:		
EF-13 (SEQ NO. 3) / EF-1 (S FOUND CONCRETE MONUMEN	SEQ. NO.1) Twith Cabeston wo	F I 2 ON I INC DETURE	NI F 12 4 CEO	211	
SKETCH ON BACK OF CERTIF	TICATE		,		
REPLACED CAP W/ALLEGAN O THIS MONUMENT IS ACCEPTED	O. REMON CAP. THIS PO	SITION NOT ESTABLISH	HED BY G.L.O.		
OF THE CORNER.	AS THE BEST AVAILAR	SLE EVIDENCE OF THE I		REMONUMENTAT	TON CODNED
A POROVED DV ALLEO AN DEED	CDC/ID II I/OII on			P.A. 345 OF 1990 ALLEGAN COUNT	
-APPROVED BY ALLEGAN PEER			DATE APPR	OVED	97
C. Description of monument for corner	and accessories establish	ned to perpetuate locating	the position of	the corner:	<i>.</i>
EF-13 / EF-1			ş.	OF MION	'es
(SEQ. NO. 3) / (SEQ. NO. 1) CONCRETE MONUMENT WITH			مربر ا	de	
-16D & REMON TAG SOUTHEAS			illy tement	ARTHUR W.	17. 1
-16D & REMON TAG SOUTH SID	E TWIN 8" MAP		*	PRINTNALL LAND	
 -16D & REMON TAG SOUTH SID -16D & REMON TAG WEST SIDE 				SURVEYOR No.	,
-EAST EDGE DUMONT LAKE	WEST			28407	do in
-SOUTH EDGE COUNTY PARK I -F-13 (T-3N, R-13W)	AWN NORTH 39' <u>+</u> EAST 637.00'		**************************************	LAND SUR	A Charles
-SEQ NO. 1 (T-3N, R-13W)	WEST 5334.74'			See THIS	
Signed by Orthun W. Br	intralli	Date Dec.	2.1997		
Prein & Newhof	· · · · · · · · · · · · · · · · · · ·	, , , , , , , , , , , , , , , , , , ,			
Surveyor's Michigan License No.	#28407	•			
		FORM APPROVED BY MICHIGAN	STATE BOARD OF PRO	REVI	SED MAY 14, 1975
LISTR 0006 PAGE 012				RI	EVISED JAN., 198: VISED OCT., 199:

PAGE 1 OF 2

EF-13 MONTEREY (SER. #3) LISTROOOGPACE 013 EF-1 ALLEGAN (SEQ. #1)



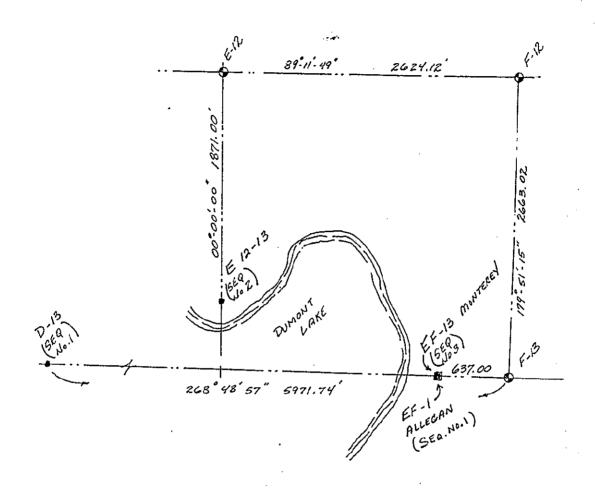

. * :

.: -

4