

ALLEGAN CO. REMONUMENTATION
LAND CORNER RECORDATION CERTIFICATE
Filing Requirement of Act 74, Mich. P.A. 1970

FILED

1/28/1999 2:44:39 PM

JOYCE A. WATTS
REGISTER OF DEEDS
ALLEGAN COUNTY, MICH

Register of Deeds Stamp & File Number

For corners in Allegan County

ALLEGAN
(County)

Located in:

Corner Code #

1. Public Land Survey

T-2N R-13W

D-1-2
SEQ #2
ALLEGAN TWP

2. Property Controlling
in Section

S T R
S T R

3. Miscellaneous
Property in Sec.

S T R
S T R

4. Lot No. _____, Recorded Plat _____

5. Private Claims _____

I, ARTHUR W. BRINTNALL, in a field survey on 27 AUG 19 98 do hereby state that under requirements of P.A. 74, Michigan P.A. of 1970, the corner points mentioned in lines 1 and 2 above were in conformance with regulations and rules therefore as required in the current manual of survey instructions of the United States Department of the Interior, Bureau of Land Management or by a decree of a Court of Law and/or that the corner points mentioned in lines 3, 4 and 5 above were in conformance with the rules of the Michigan Board of Land Surveyors or by a Decree of a Court of Law; established, re-established, monumented, recovered, found as expressed below:

NOTE: Not more than 2 corners, all in the same town and range, may be recorded on this certificate.

A. Description of original monument and accessories and/or subsequent restoration:

G.L.O.

THIS POSITION WAS NOT ESTABLISHED BY G.L.O.

NOV 9, 1869 J.W. HICKS, C.S.

ROAD SURVEY

SET A PT 25.00 CHS N OF CENTER ON N-S 1/4 LINE

D.A. RATEKIN, C.S. WITNESS CARD

ANGLE ON E. SDE OF CENTER OF 179°-16'

B. Description of corner evidence found and/or method applied in restoring or reestablishing corner:

FD 1" IRON BETWEEN CUL-DE-SAC AND DUMONT LAKE 1900.00' N OF D-2
ANGLE @ CENTER ON EAST OF 179°-15'-30" THIS LINE FITS R/W IRONS FD
ALG W. SDE OF 33RD ST NORTH OF CENTER (D-2)

REPLACED 1" IRON WITH STD. A.C. MON (3/4" X 36" IRON WITH CAP)
THIS POSITION NOT ESTABLISHED BY G.L.O. THIS MONUMENT IS
ACCEPTED AS THE BEST AVAILABLE EVIDENCE OF THE POSITION OF THE CORNER.

APPROVED BY ALLEGAN PEER GROUP 11 AUG 98

C. Description of monument for corner and accessories established to perpetuate locating the position of the corner:

STD A.C. MON (3/4" X 36" IRON WITH CAP)
NAIL & REMON TAG S SDE 28" WILLOW S 85° E 75.04'
NAIL & REMON TAG E SDE 12" ASH N 05° W 42.17'
NAIL & REMON TAG SE SDE TWIN 4' MAPLE S 10° W 51.93'
NAIL & REMON TAG SW SDE 10" ASH S 45° E 178.40'
SOUTH EDGE DUMONT LAKE NORTH 89'±
N E/B (CUL-DE-SAC) SOUTH 41'±
IN LINE WITH CENTERLINE 33RD ST TO SOUTH

Signed by


PREIN&NEWHOF

Surveyor's Michigan License No. #28407

Date

APPROVED REMONUMENTATION CORNER
P.A. 345 OF 1990
ALLEGAN COUNTY
DATE APPROVED Aug 11, 1998
COUNTY REP. [Signature]

	A	B	C	D	E	F	G	H	I	J	K	L	M
1													
2		6		5		4		3		2		1	
3													
4		7		8		9		10		11		12	
5													
6		18		17		16		15		14		13	
7													
8		19		20		21		22		23		24	
9													
10		30		29		28		27		26		25	
11													
12		31		32		33		34		35		36	
13													

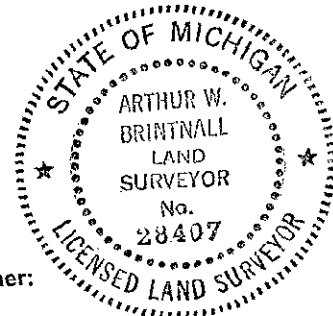

D 1-2 (Seq. # 2)
ALLEGAN TWP.

