

MAR 07 2000

SECTION

ALLEGAN COUNTY REMONUMENTATION  
LAND CORNER RECORDATION CERTIFICATE  
Filing Requirement of Act 74, Mich. P.A. 1970

00 FEB -1 AM 8:38

LIBERO 007 PAGE 208

For corners in

Allegan

(County)

Located In:

Corner Code #

1. Public Land Survey T2N R15W  
T R  
T R  
T R
2. Property Controlling S T R  
in Section S T R
3. Miscellaneous S T R  
Property in Sec. S T R

BC-6, Sequence

No. 2

East 1/4 corner  
Section 18  
Clyde Twp.

Register of Deeds Stamp & File Number

4. Lot No. \_\_\_\_\_, Recorded Plat \_\_\_\_\_
5. Private Claims \_\_\_\_\_

I, Steve Lampen, in a field survey on December 22, 1999, do hereby certify that under requirements of P.A. 74, Michigan P.A. of 1970, the corner points mentioned in lines 1 and 2 above were in conformance with regulations and rules therefore as required in the current manual of survey instructions of the United States Department of the Interior, Bureau of Land Management or by a decree of a Court of Law and/or that the corner points mentioned in lines 3, 4 and 5 above were in conformance with the rules of the Michigan Board of Land Surveyors or by a Decree of a Court of Law; established, re-established, monumented, re-monumented, recovered, found as expressed below:

NOTE: Not more than 4 corners, all in the same town and range, may be recorded on this certificate.

A. Description of original monument and accessories and/or subsequent restoration:

C-6

GLO - 1831 - C. Britain

Set post

Tamarack 8 S 76 W 17

Tamarack 4 N 73 1/2 E 15

1993 - G. Bilow - L.C.R.C, L4, P181

Set a reference corner 25' East on the East-West 1/4 line. Actual corner re-established at the intersection of the centerline of the Black River Drain with a North-South ditch centerline. Reference corner - 1/2"x36" rebar encased in a 4" diameter concrete cylinder and with a cast aluminum Michigan Department of

Natural Resources tablet

E 1' steel fence post

W 6' edge of ditch bank

W 25' centerline North-South ditch

N 30'± ditch going E

B. Description of corner evidence found and/or method applied in restoring or reestablishing corner:

C-6 Found DNR reference corner monument. Corner falls in drain. Set Standard Allegan County 3/4"x36" remonumentation iron with yellow cap #23520 on E and W 1/4 line 39.67' West of true corner. See Sketch on back.

Approved by the Allegan County Remonumentation Peer Group on December 28, 1999, and is accepted as a careful and faithful re-establishment of the position of the original corner.

Traversed off road 5315'

APPROVED REMONUMENTATION CORNER

P.A. 345 OF 1990

ALLEGAN COUNTY


DATE APPROVED DEC. 28, 1999

COUNTY REP. *[Signature]*

C. Description of monument for corner and accessories established to perpetuate locating the position of the corner:

BC-6, Sequence No. 2 Standard Allegan County 3/4"x36" remonumentation iron with yellow cap #23520 39.67' W of the true corner on E and W 1/4 line of Section 18

1/2" diameter steel bar with cap #37279	168°	12.50'
1/2" diameter steel bar with cap #37279	218°	32.50'
1/2" diameter steel bar with cap #37279	241°	23.7'
1/2" diameter steel bar with cap #37279	49°	27.2'

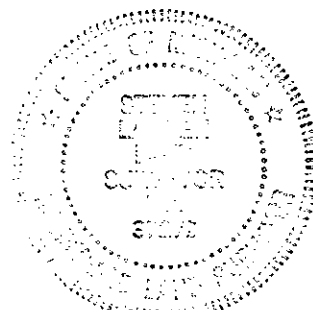

Signed by *Steven Lampen*

Date DECEMBER 31, 1999

Surveyor's Michigan License No. 37279

REVIEW &  
REVISION

MAR 07 2000

SECTION

LIBR0007 PAGE 209

