

MAR 07 2000

ALLEGAN COUNTY REMONUMENTATION  
LAND CORNER RECORDATION CERTIFICATE  
Filing Requirement of Act 74, Mich. P.A. 1970

00 FEB -1 AM 8:40

SECTION

For corners in  
Allegan  
(County)

Located In:

Corner Code #

*Joyce A. C. C. C.*  
REGISTER OF DEEDS  
ALLEGAN COUNTY, MICH.

1. Public Land Survey T2N R16W L-9, 10, Sequence  
T R No. 5  
T R  
T R  
T R North 1/4 corner  
2. Property Controlling S T R Section 25  
in Section S T R Ganges Twp.  
3. Miscellaneous S T R  
Property in Sec. S T R

Register of Deeds Stamp & File Number

4. Lot No. , Recorded Plat
5. Private Claims

I, Steve Lampen, in a field survey on December 22, 1999, do hereby certify that under requirements of P.A. 74, Michigan P.A. of 1970, the corner points mentioned in lines 1 and 2 above were in conformance with regulations and rules therefore as required in the current manual of survey instructions of the United States Department of the Interior, Bureau of Land Management or by a decree of a Court of Law and/or that the corner points mentioned in lines 3, 4 and 5 above were in conformance with the rules of the Michigan Board of Land Surveyors or by a Decree of a Court of Law; established, re-established, monumented, re-monumented, recovered, found as expressed below:

**NOTE:** Not more than 4 corners, all in the same town and range, may be recorded on this certificate.

A. Description of original monument and accessories and/or subsequent restoration:

L-9  
GLO - 1831 - C. Britain  
Set post  
Tamarack 14 S 25 W 117  
Tamarack 10 S 45 E 129

No other records recovered

B. Description of corner evidence found and/or method applied in restoring or reestablishing corner:

L-9 No corner monumentation found. Calculated corner on line and equidistant between K-9 and M-9, T2N, R16W, corner falls in East and West drain. See sketch on back.

Set Standard Allegan County 3/4"x36" remonumentation iron with yellow cap #23520 at a witness corner on N and S 1/4 line, Section 25 T2N, R16W, 33.00' South of corner.

Approved by the Allegan County Remonumentation Peer Group on December 28, 1999 and is accepted as a careful and faithful re-establishment of the position of the original corner.

Traversed on road 5195'

APPROVED REMONUMENTATION CORNER

P.A. 345 OF 1990

ALLEGAN COUNTY

DATE APPROVED DEC. 28, 1999


COUNTY REP. *[Signature]*

C. Description of monument for corner and accessories established to perpetuate locating the position of the corner:

L-9, 10, Sequence No. 5 Standard Allegan County 3/4"x36" remonumentation iron with yellow cap #23520 on N and S 1/4 line Section 25, T2N, R16W, 33.00' S of true corner.

Azimuth = Michigan State Plane grid direction

12" Ash with remonumentation tag E side	51° 53'	9.52'
6" Ash with remonumentation tag S side	297° 42'	18.32'
30" Maple with remonumentation tag NE side	152° 33'	85.16'
Power pole with remonumentation tag W side	169° 35'	101.58'
Centerline E and W gravel road	180°	15'
Centerline ditch to S	90°	28'
Centerline ditch to N	270°	15'

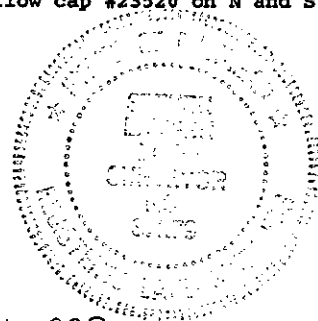

Signed by *Steve Lampen*

Date DECEMBER 31, 1999

Surveyor's Michigan License No. 37279

SURVEY &  
RECONSTRUCTION

MAR 07 2000

SECTION

LIBRO U / PAGE 11

