

FILED

MAR 07 2000

ALLEGAN COUNTY REMONUMENTATION
LAND CORNER RECORDATION CERTIFICATE
Filing Requirement of Act 74, Mich. P.A. 1970

00 FEB -1 AM 8:41

LIBRARY / FILE 311

SECTION

For corners in

Allegan

(County)

Located In:

Corner Code #

Hopkins Twp.

T 3N R 12W

K-2

1. Public Land Survey

T R

T R

T R

T R

2. Property Controlling
in Section

S T R

S T R

3. Miscellaneous
Property in Sec.

S T R

S T R

4. Lot No. _____, Recorded Plat _____

5. Private Claims _____

I, Robert J Jonker, in a field survey on 11-6, 1998 do hereby state that under requirements of P.A. 74, Michigan P.A. of 1970, the corner points mentioned in lines 1 and 2 above were in conformance with regulations and rules therefore as required in the current manual of survey instructions of the United States Department of the Interior, Bureau of Land Management or by a decree of a Court of Law and/or that the corner points mentioned in lines 3, 4 and 5 above were in conformance with the rules of the Michigan Board of Land Surveyors or by a Decree of a Court of Law; established, re-established, monumented, recovered, found as expressed below:

NOTE: Not more than 2 corners, all in the same town and range, may be recorded on this certificate.

	A	B	C	D	E	F	G	H	I	J	K	L	M
1													
2	6		5		4		3		2		1		
3													
4	7		8		9		10		11		12		
5													
6	13		17		16		15		14		13		
7													
8	19		20		21		22		23		24		
9													
10	30		29		28		27		26		25		
11													
12	31		32		33		34		35		36		
13													

A. Description of original monument and accessories and/or subsequent restoration:

G.L.O

Corner is the NW. Corner of Rolling Acres Plat

APPROVED REMONUMENTATION CORNER
P.A. 345 OF 1990
ALLEGAN COUNTY

DATE APPROVED NOV. 10, 1998
COUNTY REP. John A. Van Dine

B. Description of corner evidence found and/or method applied in restoring or reestablishing corner.

Found pk. nail on bridge deck-took witnesses prior to construction

A/C tag-N. side 22" ash N74°W 40.06'

A/C tag-S. side 14" Elm N70°E 50.15'

A/C tag & pk. nail-NE. side p. pole N61°W 97.98'

A/C tag-NE. side 15" Elm S27°E 81.19'

set iron on sec. line - South 1409.32' in line S. edge house #3469-1/2 mile = 2659.88'

Reset corner on 12-8-99 after new bridge was constructed from the witnesses listed in B above

And is accepted as a careful and faithful perpetuation of the position of the original corner.

Peer group approved 11-10-98

C. Description of monument for corner and accessories established to perpetuate locating the position of the corner:

3/4" X 3" std. capped Allegan Co. Monument

"X" cuts on top concrete wing-wall N50°E 22.36'

"X" cuts on top concrete wing-wall S25°E 49.57'

"X" cuts on top concrete wing-wall S20°W 50.56'


"X" cuts on top concrete wing-wall N55°W 22.25'

"X" cuts on top concrete wing-wall S85°W 17.87'

Cut mark on C/L "I" beam N90°E 16.85'

Cut mark on C/L "I" beam

On C/L N-S pavement.

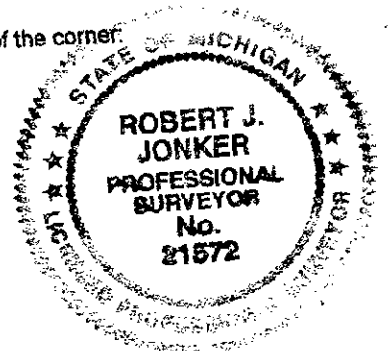

Signed by

Robert J. Jonker

Surveyor's Michigan License No. 21572

Date 12-10-99