

SECTION

ALLEGAN COUNTY REMONUMENTATION  
LAND CORNER RECORDATION CERTIFICATE  
FILING REQUIREMENT OF ACT 74, MICH. P. A. 1970

FILED

FOR CORNERS IN:  
ALLEGAN COUNTY

LOCATED IN:

CORNER CODE #

1/28/1999 2:44:39 PM

1. Public Land Survey

T. 3N. R. 13W

E-5.....

SEC. COR COMMON  
TO SEC. 8, 9, 16 & 17  
MONTEREY TWP.

T. .... R. ....

T. .... R. ....

T. .... R. ....

2. Property Controlling  
in section

S. .... T. .... R. ....

S. .... T. .... R. ....

3. Miscellaneous  
Property in Sec.

S. .... T. .... R. ....

4. Lot No. .... Recorded Plat. ....

5. Private Claims. ....

I, Raymond Moored in a field survey on Aug. 5, 1998 do hereby state that under requirements of P.A. 74, Michigan P.A. of 1970, corner points mentioned in lines 1 and 2 above were in conformance with regulations and rules therefore as required in the current manual of survey instructions of the United States Department of the Interior, Bureau of Land Management or by a decree of a Court of Law and/or that the corner points mentioned in the lines 3, 4, and 5 above were in conformance with the rules of the Michigan Board of Land Surveyors or by a Decree of a Court of Law; established, monumented, recovered, found as expressed below.

Note: Not more than 2 corners, all the same town and range, may be recorded on this certificate.

REGISTER OF DEEDS STAMP & FILE NUMBER

	A	B	C	D	E	F	G	H	I	J	K	L	M
2	6	5			4		3		2		1		
3													
4	7	8			9		10		11		12		
5													
6	16	17			16		15		14		13		
7													
8	19	20			21		22		23		24		
9													
10	30	29			28		27		26		25		
11													
12	31	32			33		34		35		36		
13													

A. Description of original monument and accessories and/or subsequent restoration:

\* SEE BACK OF SHEET FOR CORNER HISTORY \*

APPROVED REMONUMENTATION CORNER  
P.A. 345 OF 1990  
ALLEGAN COUNTY  
DATE APPROVED SEPT. 8, 1998  
COUNTY REP. [Signature]

B. Description of corner evidence found and/or method applied in restoring or reestablishing corner:

FOUND 1" SQUARE IRON BAR PER HOLLAND ENGINEERING SECTION CARD NOTES.  
SET 3/4" X 24" ALLEGAN COUNTY REMON IRON W/REMON CAP IN PLACE OF FOUND CORNER.

ACCEPTED POSITION AS A CAREFUL AND FAITHFUL PERPETUATION OF THE POSITION OF THE ORIGINAL CORNER.

PEER GROUP APPROVED SEPT. 8, 1998


C. Description of monument for corner and accessories established to perpetuate locating the position of the corner:

SET STANDARD ALLEGAN COUNTY REMONUMENTATION IRON WITH CAP.  
-FRONT CORNER OF HOUSE S.S.W. - 125.15' (HOUSE #3204)  
-NAIL & TAG IN WEST SIDE 30" MAPLE TREE S60E 47.45'  
-CENTER OF STOP SIGN POST N25W 35.35'  
-NAIL & TAG IN SE SIDE 38" MAPLE N25E 108.50'

[Signature]

Date 9/18/98

Surveyors License No. 26463

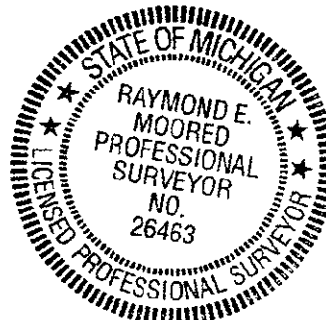

**SURVEY  
REMONUMENTATION**

**APR 29 1955**

**SECTION**

**GOVERNMENT CORNER HISTORY**

**SECTION CORNER COMMON TO SECTIONS 8, 9, 16 & 17  
TOWN 3 NORTH, RANGE 13 WEST**

**E-5**

**1. G.L.O.**

80.00 SET POST COR SEC 8, 9, 16 & 17  
A W. OAK 15 IN DIA BEARS S20W 14LKS DIST  
A W. OAK 12 IN DIA BEARS N34E 44 LKS DIST

**2. KIRK VAN ORDER, 05-02-79, L.C.R.C. LIBER 03 PAGE 256**

FD. 1" SQ. IRON BAR  
T. POLE NE 40.80'  
38" MAPLE SE 47.05'  
C/L COR. FENCE POST SE 36.12'  
13" MAPLE SW 56.10'

**3. HOLLAND ENGINEERING WITNESS SHEET**

FD. 1" SQ IRON BAR	HEI	79	
TP	NE	40.80	
38" MAPLE	SE	47.05	
CL COR FC POST	SE	36.12	
13" MAPLE	SW	56.10	

LIBER 006 PAGE 13