

Allegan County Remonumentation
LAND CORNER RECORDATION CERTIFICATE
Filing Requirement of Act 74, Mich. P.A. 1970

For corners in

Allegan Co.
(County)

Located in:

Corner Code #

4 twps.

1. Public Land Survey

T 4N R 12W
T 3N R 12W
T 3N R 13W
T 4N R 13W

A-13 DARR

A-1 HOPKINS

M-1 MONTEREY

M-13 SALETH

2. Property Controlling
in Section

S T R
S T R

3. Miscellaneous
Property in Sec.

S T R
S T R


SURVEY &
REMONUMENTATION

APR 29 1996

COMMISSION

Lot No. _____, Recorded Plat _____
5. Private Claims _____

Register of Deeds Stamp & File Number

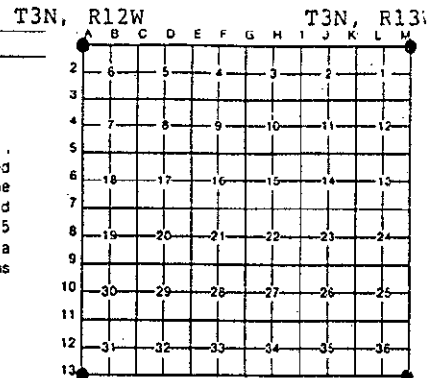

I, Robert J. Jonker, in a field survey on December 13, 1994, do hereby certify that under requirements of P.A. 74, Michigan P.A. of 1970, the corner points mentioned in lines 1 and 2 above were in conformance with regulations and rules therefore as required in the current manual of survey instructions of the United States Department of the Interior, Bureau of Land Management or by a decree of a Court of Law and/or that the corner points mentioned in lines 3, 4 and 5 above were in conformance with the rules of the Michigan Board of Land Surveyors or by a Decree of a Court of Law; established, re-established, monumented, re-monumented, recovered, found as expressed below:

NOTE: Not more than 4 corners, all in the same town and range, may be recorded on this certificate.

A. Description of original monument and accessories and/or subsequent restoration:

G.L.O. survey, May 3, 1831, P. 231, & P. 259
Lucius Lyon, D.S.
Beech 17 S 50° E 12
Beech 7 N 25° W 36

1972, Russ Donker, Iron
14" Maple NNE 27.0'
24" Oak SW 34.7'
28" Oak SE 55.0'

T4N, R12W T4N, R13W
LCRC, L.3, P.211, Ratekin
Fd. 1" Pipe, 1978, In C/L road
PK NW side 24" Oak S34°W 35.70'
PK SW side 30" Oak S55°E 56.06'
PK SE side 12" Hickory N30°E 27.57'
PK E. side P. pole N10°E 55.71'

B. Description of corner evidence found and/or method applied in restoring or reestablishing corner:

Found 1" Iron pipe by all the witnesses located in "A" above for the recorded L.C.R.C.

APPROVED REMONUMENTATION CORNER

P.A. 345 OF 1990

ALLEGAN COUNTY

DATE APPROVED


COUNTY REP.

This monument is accepted by me as a careful and faithful perpetuation of the position of the corner.

Peer group approved on 12-14-95.

C. Description of monument for corner and accessories established to perpetuate locating the position of the corner:

Replaced and set 3' std. Allegan County monument, capped with remon. cap.
A/C Nail & tag, W. side P. pole N 00° E 56.32'
A/C Nail & tag, N. side 24" Oak S 80° W 124.0'
A/C Nail & tag, E. side 30" Oak S 35° W 34.98'
A/C Nail & tag, W. side 10" Sas. S 10° E 53.68'
on C/L E-W road
Capped Iron S. 32.94'

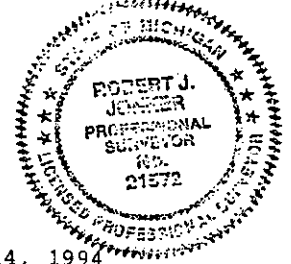

Signed by Robert J. Jonker

Date December 14, 1994

Surveyor's Michigan License No. JONKER LAND SURVEYS

21572

0005 PAGE 222