
APR 0 7 1998

SECTION For corners in	LAND CORM	COUNTY REMONUME NER RECORDATION Lirement of Act 74, Mi	CERTIFICA		Sorgic Sorgic	NAT 86	TI
Allegan	Located in: Co	orner Code#	1.00			21	=
(County) 1. Public Land Survey	T R T R T R	DE-1 Heath Twp.	*(#4)		公のなる。	PH 1: 23	I MO
Property Controlling in Section Miscellaneous Property in Sec.	S 5 (3N R 14V) S 32 T4N R 14V S T R S T R	Overisel Twp.	. #0)	Registe	r of Deeds St		e Number
4. Lot No, Record 5. Private Claims	led Plat		-	A B C	D E F (3 H I	J K L M
I. <u>Kirk L. Van Order</u> , requirements of P.A. 74, Michigan conformance with regulations and r United States Department of the In that the corner points mentioned it Board of Land Surveyors or by recovered, found as expressed between	P.A. of 1970, the corner points rules therefore as required in the of terior, Bureau of Land Managema n lines 3, 4 and 5 above were in o a Decree of a Court of Law; e	mentioned in lines 1 and 2 current manual of survey instread or by a decree of a Court conformance with the rules of	above were in ructions of the of Law and for I the Michigan	4 - 7 - 5 - 18 - 19 - 8 - 19 - 19 - 19 - 19 - 19	- 8 - 9 - 9 - 17 - 16 - 1 - 10 - 20 - 21 - 1	io	1112
NOTE: Not more than 2 come on this certificate.	ers, all in the same town and ra	inge, may be recorded		9	292B	27	26-25-
OIT this certificate.				11			
	•			12 -31-	_3233	34	3536
A. Description of original mor	jument and accessories and/	APPROVED I	REMONUMENT P.A. 345 OF 19 ALLEGAN COU OVED//-	90 NTY	ER		
Section 5, T. highland East AZ 91°14′02" AZ 271°14′02" AZ 91°-14′02" AZ 271°14′02" This position monument is a	Allegan County (3N., R.14W. and of bayou being 1382.47 feet (1258.04 feet (1452.33 feet (1182.14 feet (n not establish ccepted as the h	witness monum d Section 32, from computed from computed from computed from computed from computed ed by originates est available	T.4N., position position position position position position al goven evidence	R.14W. n D-1, n E-1, n D-13, n E-13. rnment ee of th	and surveyo	rs.	This
Peer group at C. Description of monument Set standard plastic car Nail & Remon Nail & Remon	Allegan County w	itness monume: 17" Hemlock 20" Hemlock 10" Hemlock	ocating the point (3/4." AZ 2 AZ 3 AZ 1 AZ 1	X 36" 85° 50° 00°	18.96' 23.33' 21.54' 31.88'	d w/y€	:llow
Signed bySurveyor's Michigan License I	1 Jan Onder	<i></i>	Date	12.31	-97		

Page 1 of 2
FORM APPROVED BY MICHGAN STATE BOARD OF PROFESSIONAL SURVEYORS, JAN. 28, 1971
REVISED MAY 14,1975
REVISED JAN, 1983
REVISED CCT., 1995

UET 0006 PAGE 109

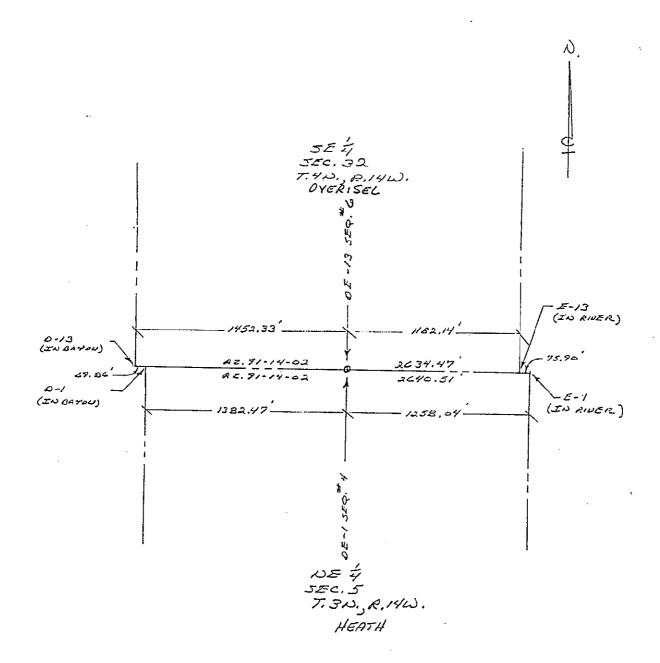

Page 2 of 2