
\$	98		
<u>}</u> {	يــ	רד	

SECTION SECTION	Filing	Requirement of Act	74, Mich. P.A. 197	0	- CO	98			
Allegan (County)	Located in:	Corner Code #	other		FGISTER C	JAN 21	FILED		
I . Public Land Survey	TR TR TR	DE-1 Heath Twp DE-13 Overisel			LER OF DIASS.	PH 1: 2	m D		
2. Property Controlling in Section 3. Miscellaneous Property in Sec.	S 5 T R S T R	Heath Two			ę;	ŧ.			
Troporty in ooo.			<u> </u>	Registe	r of Deeds St	amp & Fi	e Muniper		
4. Lot No, Record 5. Private Claims	ed Plat			A B C	D E F G	ні	JKLN		
				2 6					
Kirk L. Van Order	in a field survey on	oct. 23, 19 97 do he	reby state that under	4 - 7 -	- 8 9	-10-	-1112		
requirements of P.A. 74, Michigan conformance with regulations and rulnited States Department of the International Conference	ules therefore as required i	n the current manual of sur	ey instructions of the	5 ,	_1216		1413		
that the corner points mentioned in Board of Land Surveyors or by a	allines 3, 4 and 5 above we all Decree of a Court of I	re in conformance with the	rules of the Michigan	7			11-		
recovered, found as expressed belo NOTE: Not more than 2 come		and made may be texted	ort.	9 -19	_2021	22-	-2324		
on this certificate,	is, and the same town.	ald failge, may be record	-	10 30		27	-2625		
				12 31	_3233	_34	-3536		
A. Description of original mon	ument and accessories	and/or subsequent res	oration:	13		<u> </u>			
2 Dodgiposi et oligino titori		•							
	APPROVED REMONUMENTATION CORNER P.A. 345 OF 1990								
ALLEGAN COUNTY DATE APPROVED									
						•			
B. Description of corner evid Set standard A Section 5, T.		itnocc mot	nument on No	orth an	d South respect	line	s of y on		
highland on We	et side OT K	abbit kiver b	eung		_				
AZ 2/1°14'02" AZ 271°14'02" AZ 91°14'02"	220 58 fee	t trom comput	ea position	. E-L,	and				
M2 91 14 02	2389.79 fe	et from compu	ted positio	n D-13	•	s.	This		
This position monument is accorner.	cepted as the	a best avalla	ole evidence	e or cu	e bosici	on of			
Peer group apr C. Description of monument	proved Nov. 1 or corner and accessor	1 1997 . nes established to perpe	tuate locating the po-	sition of the	corner:				
Set standard A	llegan County	witness monu	ment (3/4"	x 36" s	teel roo	i w/ye	llow		
plastic cap	#23520) tag in NW si	de 10" Red Oa	ık AZ 2	0°	11.32'				
Nail & Remon.	tag in NE Sl	de 2/" Red Ud de 13" W. Oal	AZ 2	200°	18.77'				
Nail & Remon. Top of bank	tag in NW si	de 8" Red Oal,		270° 90°	22.30'				
	/	,							

Page 1 of 2

 $11573 0006_{\text{PAGE}} 111$

Surveyor's Michigan License No.

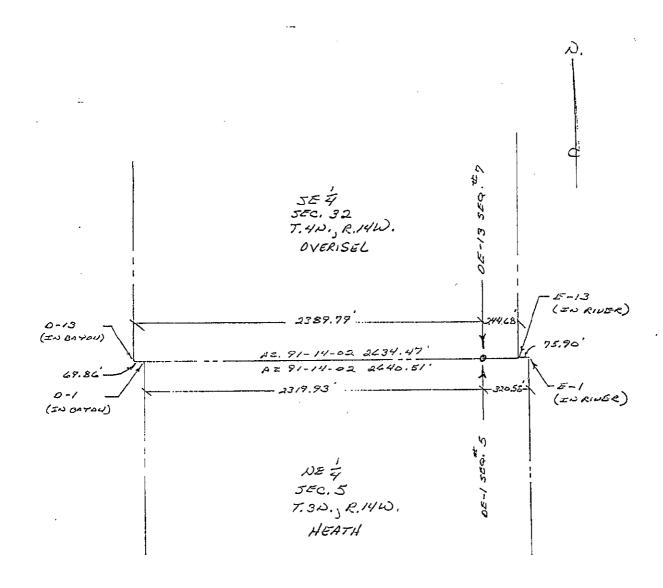

Page 2 of 2