
APR 071	998						
SECTION	LÁND	LLEGAN COUNTY REMODE CORNER RECORDAT G Requirement of Act 74	ION CERTIFICA	TE 70	S 8		
Allegan	Located In:	Corner Code #	١,	VI 18	3 -	73	
(County)			ANKA	GAN (	JAN 2	=	
1. Public Land Survey	TR_ TR_ TR	EF-1 Heath Twp. / EF-13 Overisel (	(#46)	COUNTY C	(S) 문 (S) 트	FILED	4
2. Property Controlling in Section 3. Miscellaneous Property in Sec.	S 4 T 3N R S 33 T 4N R S T R S T R	14W Heath Twp.		Register of Dec	· #=	File Numb	<b>B</b> r
Property in oco.	<u> </u>	<del></del>	<u> </u>	Register of Dec	us stamp a i	de Hamb	
4. Lot No, Record 5. Private Claims	ed Plat			A B C D E  1  2  6  3	F G H 1	I J К	<u>ر</u> ا
I. Kirk I. Van Order . requirements of P.A. 74, Michigan conformance with regulations and funited States Department of the In that the corner points mentioned it Board of Land Surveyors or by	4 7 8 5 6 -18 -17 7 8 -19 -20	-1615-	-14	13-			
recovered, found as expressed belonger				9   -   -			Ţ
NOTE: Not more than 2 comers, all in the same town and range, may be recorded on this certificate.				10-30-29	_2827	26	 25 
				11 32 32	_3334	35	36- 
A. Description of original mor	nument and accesso	ries and/or subsequent resto	oration:	13	!!!	· · · · · · · · · · · · · · · · · · ·	-\-
			P.,	IONUMENTATION CO A. 345 OF 1990	RNER		
			DATE ADDROVE	EGAN COUNTY ED			
			COUNTY REP	K.Y.0.			

В.	Description of corner evidence found and/or method applied in restoring or re-	establishin	ig conten.	th and Couth lines C	٦f				
	Set standard Allegan County witness monu	ment o	on Nor	th and South Lines C	ייי מי				
	A m 3N R. AW. and Section 3.	, T+21	1107 **	.14W. respectively c	/11				
	- 1 '.L lord on Fact side Of Kabble At	EL DE.	****						
	canalina and 10 toot from Combuleu	DOST F	7011 1	13,					
	actor 4 con 2222 20 foot from computed position frid;								
	^1^1/1/01 776 70 TAAT TEOM COMPULED DOSECTOR/								
					i.s				
	This position not established by origin	nai go	overim	of the position of the					
	This position not established by original monument is accepted as the best available.	е елто	Teuce	or the possession					
c.	Peer group approved Nov. 11, 1997. Description of monthment for corner and accessories established to perpetua	e locating t	the positio	n of the corner:					
	Set standard Allegan County witness monum	ent (3	/4" x	36" steel rod W/Yello	OW				
	can #235201								
	Wail's Person, tag in NE side 9" ASR	AZ 31		70.74'					
	wall a Remon fact in E Side 9" ASH	AZ 00	) •	105.73′					
	Nail & Remon. tad in N Side 42" D. Ash	AZ 95	, ,	47.87′ 68.60′					
	Nail & Remon. tag in N side is bim	AZ 11	15*	16'+/-					
	North edge of Rabbit River	AZ 18	30.	39.5'+/-					
	East edge of Rabbit River	AZ 27 AZ 00	10	0.5					
	C/L steel fence post	AZ UU	,	V.5					
	11/1/19/			10 0: 07					
Si	gned by Mind I Van Under	Date_		12-31-97					
	23520								

Page 1 of 2

 $\mathsf{HETR}0006_{\mathsf{PAGE}}114$ 

FORM APPROYED BY MICHIGAN STATE BOARD OF PROFESSIONAL SURVEYORS, JAN. 26, 197 REVISED MAY 14, 197 REVISED JAN., 198

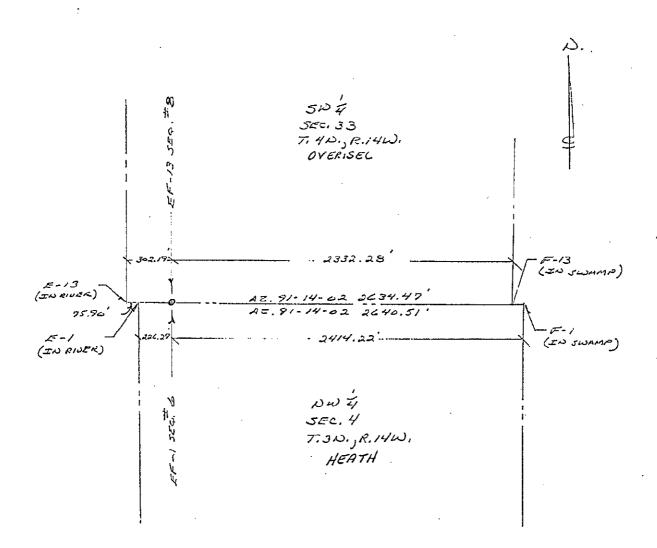

Page 2 of 2