
SURVEY & REMONUMENTATION

| APR 0 7 1998 ALLEGAN COUNTY REMONUT LAND CORNER RECORDATION Filing Requirement of Act 74, | ON CERTIFICATE |
|---|--|
| For corners SECTION | I Exal |
| Located In: Corner Code # | JAN 21 PH |
| 1. Public Land Survey | |
| 2. Property Controlling in Section S 4 T3N R14W Heath Twp. 3. Miscellaneous Property in Sec. S T R | |
| 4. Lot No, Recorded Plat | ABCDEFGHIJKLM |
| 5. Private Claims | 2 6 5 4 3 2 - 1 - 3 |
| I, <u>KIrk L. Van Order</u> , in a field survey on <u>Dec. 1</u> , 19 <u>97</u> do hereb requirements of P.A. 74. Michigan P.A. of 1970, the corner points mentioned in lines 1 and conformance with regulations and rules therefore as required in the current manual of survey in United States Department of the Interior, Bureau of Land Management or by a decree of a Chat the corner points mentioned in lines 3, 4 and 5 above were in conformance with the rule Board of Land Surveyors or by a Decree of a Court of Law; established, re-established recovered, found as expressed below: | d 2 above were in 5 instructions of the 5 out of Law and for 6 18 17 16 15 14 13 es of the Michigan |
| NOTE: Not more than 2 comers, all in the same town and range, may be recorded on this certificate. | 9 10 30 29 28 27 26 25 11 |
| A. Description of original monument and accessories and/or subsequent restore | 12 31 32 33 34 35 36 36 36 36 36 36 36 36 36 36 36 36 36 |
| | APPROVED REMONUMENTATION CORNER P.A. 345 OF 1990 ALLEGAN COUNTY DATE APPROVED //-//-97 COUNTY REP. K.V.O |
| B. Description of corner evidence found and/or method applied in restoring or Set standard Allegan County witness mont Section 4, T.3N., R.14W. and Section 3 higher lowland on West side of Rabbit Ri AZ 91°14′02" 405.66 feet from computed AZ 271°14′02" 2234.85 feet from computed AZ 91°14′02" 481.56 feet from computed AZ 271°14′02′ 2152.91 feet from computed This position not established by originanument is accepted as the best available corner. Peer group approved Nov. 11, 1997. | thent on North and south lines of 13, T.4N., R.14W. respectively on liver being it position E-1, ted position E-1, it position E-13, and ad position F-13. |
| C. Description of monument for corner and accessories established to perpetue Set standard Allegan County witness monuments. | ate locating the position of the corner. ment (3/4" x 36" steel rod w/yellow |
| cap (#23520) Nail & Remon. tag in NW side 26" Poplar Nail & Remon. tag in SW side 21" Poplar Nail & Remon. tag in NE side 20" Poplar Nail & Remon. tag in S side 9" Ash North edge of Rabbit River West edge of Rabbit River | AZ 310 22.74 |
| Signed by Kind of Van Onter | Date |
| Surveyor's Michigan License No. 23520 | <u>.</u> |
| Pega 1 o | \f ? |

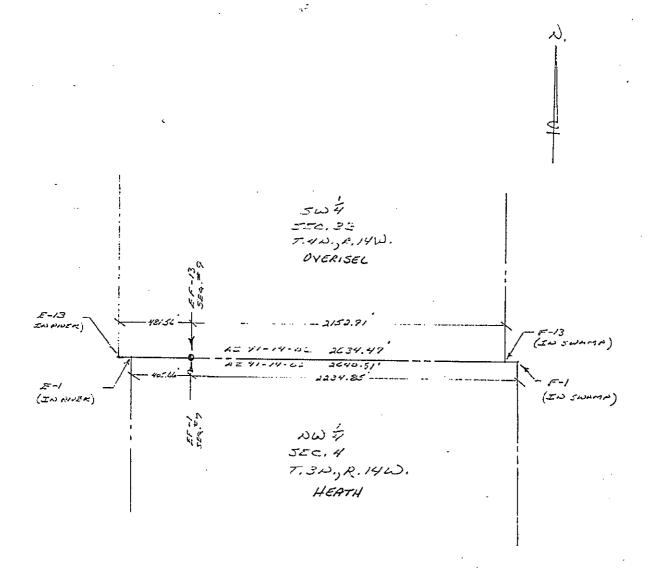

Page 2 of 2