

FILED

MAR 07 2000

Allegan County Remonumentation
LAND CORNER RECORDATION CERTIFICATE
 Filing Requirement of Act 74, Mich. P.A. 1970

20 FEB -1 AM 8:39

Jayce A. Smith
 REGISTER OF DEEDS
 ALLEGAN COUNTY, MI

RECORDED / FILED

For corners in
 Allegan

SECTION

Located In:

Corner Code #
 D-11 (South 1/4 29)
 Dorr Twp.

1. Public Land Survey

4N 12W
 T R
 T R
 T R
 T R

2. Property Controlling in Section

S T R
 S T R

3. Miscellaneous Property in Sec.

S T R
 S T R

Register of Deeds Stamp & File Number

4. Lot No. _____, Recorded Plat _____
 5. Private Claims _____

I, Steven Koerber, in a field survey on June 4, 19 99 do hereby state that under requirements of P.A. 74, Michigan P.A. of 1970, the corner points mentioned in lines 1 and 2 above were in conformance with regulations and rules therefore as required in the current manual of survey instructions of the United States Department of the Interior, Bureau of Land Management or by a decree of a Court of Law and/or that the corner points mentioned in lines 3, 4 and 5 above were in conformance with the rules of the Michigan Board of Land Surveyors or by a Decree of a Court of Law; established, re-established, monumented, recovered, found as expressed below:

NOTE: Not more than 2 corners, all in the same town and range, may be recorded on this certificate.

A	B	C	D	E	F	G	H	I	J	K	L	M
1												
2	6		5		4		3		2		1	
3												
4	7		8		9		10		11		12	
5												
6	18		17		16		15		14		13	
7												
8	19		20		21		22		23		24	
9												
10	30		29		28		27		26		25	
11												
12	31		32		33		34		35		36	
13												

A. Description of original monument and accessories and/or subsequent restoration:

D-11 GLO - L. Lyon DS 1831 1. April 12, 1876
 Beech 14 S68°W 23 J.W. Hicks
 Maple 16 N12°W 18 S&S&Iron
 Oak 16 NW 21'
 Oak 16 NE 22'

2. Section breakdown notes from old Co. Surv.
 Dist from D-10 to D-11 2630.09' Second dist 2629.47'

(Additional info. on back of sheet)


B. Description of corner evidence found and/or method applied in restoring or reestablishing corner:

D-11 Found
 Fnd "T" Iron
 Nail in face 24" Oak NE 55.16'
 Nail in face 15" Oak ESE 52.13'
 USGS Mon. NE 48.97'
 Nail in face 20" Oak S-SE 20.78'
 This corner is accepted as a careful and faithful perpetuation of the position of the original corner.
 Peer Group approval June 8, 1999.
 Dist to D-10 = 2629.23'

APPROVED REMONUMENTATION CORNER
 P.A. 345 OF 1990
 ALLEGAN COUNTY
 DATE APPROVED JUNE 8, 1999
 COUNTY REP. John A. Smith

C. Description of monument for corner and accessories established to perpetuate locating the position of the corner:

D-11 Set Standard Allegan Co. Mon. (3/4" x 24" Iron Rod with Remon.cap)
 Set nail & Allegan Co. Remon. tag in E. side 24" Oak S20E 21.28'
 Set nail & Allegan Co. Remon. tag in SE side 36" Oak N35E 56.21'
 Set nail & Allegan Co. Remon. tag in NW side 12" Elm S55W 37.42'
 Set nail & Allegan Co. Remon. tag in NE side 10" Maple N55W 61.23'

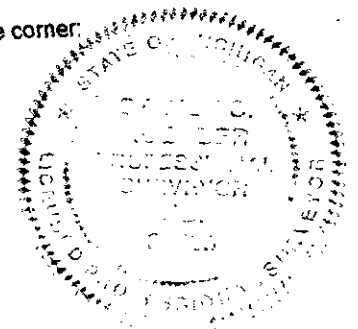

Signed by

S. Koerber

Date

8-10-1999

Surveyor's Michigan License No.

39085

D-11 DORR TWP.

RECEIVED
MAR 07 2000

MAR 07 2000

SECTION

3. Sept. 27, 1965
Act 132 survey - Donald Ratckin
No wits
4. 4-6-1973
L.C.R.C. L.2, Pg.101 Douglas Bonnema
Fnd "T" Iron
Nail in face 24" Oak NE 55.16'
Nail in face 15" Oak ESE 52.13'
USGS Mon. NE 48.97'
Nail in face 28" Oak SE 39.90'
Nail in face 20" Oak S-SE 20.78'
5. 7-12-1974
Act 132 survey Kistler & Assoc.
Same as No. 4 above
6. Witness note sheet - Holland Eng.
Same as No. 4 above
7. 7-12-1974
L.C.R.C. L.2, Pg.316 John Clapp
Fnd "T" Iron
Wits same as No. 4 above
8. 11-21-1980
Act 132 survey Exxel Eng. L. 989, Pg. 774
Nail & tag in side 24" Oak NE 55.16'
Nail & tag in Side 15" Oak ESE 52.13'
Nail & tag in side 28" Oak SE 39.90'
Nail & tag in side 20" Oak SSE 20.78'
USGS mon. NE 48.97'
9. Wightman-Moored notes
No date
"T" Iron
Same wits as No. 8 above

LIBRARY / MAR 23 1