

ALLEGAN COUNTY REMONUMENTATION  
LAND CORNER RECORDATION CERTIFICATE  
Filing Requirement of Act 74, Mich. P.A. 1970

For corners in

Allegan

(County)

Located in:

Dorr Twp.

Corner Code #

1. Public Land Survey

T 4N R 12W

E-6

T R

1/4 corner

T R

to Sections

T R

16 & 17

2. Property Controlling  
in Section

S T R

S T R

3. Miscellaneous  
Property in Sec.

S T R

S T R

FILED

1/28/1999 2:44:39 PM

JOYCE A. WATTS  
REGISTER OF DEEDS  
ALLEGAN COUNTY, MICH

Register of Deeds Stamp & File Number

4. Lot No. \_\_\_\_\_, Recorded Plat \_\_\_\_\_  
5. Private Claims \_\_\_\_\_

I, Robert Jonker, in a field survey on 8-03, 1998 do hereby state that under requirements of P.A. 74, Michigan P.A. of 1970, the corner points mentioned in lines 1 and 2 above were in conformance with regulations and rules therefore as required in the current manual of survey instructions of the United States Department of the Interior, Bureau of Land Management or by a decree of a Court of Law and/or that the corner points mentioned in lines 3, 4 and 5 above were in conformance with the rules of the Michigan Board of Land Surveyors or by a Decree of a Court of Law; established, re-established, monumented, recovered, found as expressed below:

NOTE: Not more than 2 corners, all in the same town and range, may be recorded on this certificate.

	A	B	C	D	E	F	G	H	I	J	K	L	M
1													
2	6	5	4	3	2	1							
3													
4	7	8	9	10	11	12							
5													
6	18	17	16	15	14	13							
7													
8	19	20	21	22	23	24							
9													
10	30	29	28	27	26	25							
11													
12	31	32	33	34	35	36							
13													

A. Description of original monument and accessories and/or subsequent restoration:

40.00 - Set gr. sec. post  
W. Ash 24 N29W 49  
Elm 15 S59E 34

(OVER)

Ratekin witnesses - iron - no date  
St. sign W 18.7'  
T. Pole NE 32.5'  
Headwall SW 28.0'  
Headwall NE 25.7'

Russ Donker - 1972  
10" BoxElder NE 27.0'  
12" BoxElder E 21.7'  
24" BoxElder SSW 41.5'

B. Description of corner evidence found and/or method applied in restoring or reestablishing corner:

Found 1/2" (ID) 1" (OD) x 18" pipe per witnesses noted on rear


And is accepted as the best available evidence of the position of the original corner.

APPROVED REMONUMENTATION CORNER  
P.A. 345 OF 1990  
ALLEGAN COUNTY  
DATE APPROVED NOV. 10, 1998  
COUNTY REP. [Signature]

C. Description of monument for corner and accessories established to perpetuate locating the position of the corner:

Replaced with 3/4" x 36" std. capped Allegan County Monument.

A.C. Remon tag on WNW side 42" Hickory	S25°W 42.34'
A.C. Remon tag on SW side 14" W. Cherry	N50°W 19.46'
A.C. Remon tag on NW side 19" Tree	N62°E 27.97'
Found nail in S side 20" W. Cherry	S81°E 42.05'
"X" cut on S. end of 15" conc. curb	S39°W 44.51'
PK Nail on W. side P. pole	N25°E 143.83'
A.C. Remon Tag on N. side 20" BoxElder	N88°W 35.42'

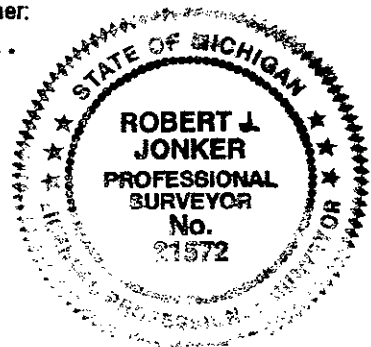

Signed by Robert J. Jonker  
Surveyor's Michigan License No. 21572

Date November 06, 1998

SHEET 1 OF 2

E-6  
DORR TWP.

Part "A" con't.

- ) Ratekin - 1975 - survey
  - PK E side 42" Maple N10°W 80.37'
  - PK SE side 20" Maple S45°W 34.24'
  - PK S side 14" Cherry S85°E 41.98' - Found 1998
  - NW cor. poured conc. wall N55°E 118.23'
  - 1" Iron S 16.78'
  - C/L gravel road, E. 3'
- ) E-6 L.C.R.C., L3, P309, June 1981, Exxel Eng. Doug Bonnema
  - Part A - blank
  - Part B - Found 1" iron that checks with previous witnesses
  - Part C - Nail S'ly side 12" W. Cherry S85°E 41.99' - Found 1998
  - Nail SW side 8" W. Cherry N45°W 19.58' - Found 1998
  - Nail E'ly side 42" Maple N10°W 80.42'
  - Nail NW side 32" Hickory S25°W 42.39' - Found 1998
- ) Wightman Moored - 1993 - 1" pipe
  - PK W side P.Pole NNE 173.48'
  - NW cor. house fndn. NE 118.22'
  - SW cor. porch fndn. ENE 106.18'
  - Nail S side 17" Cherry E 42.02' - Found 1998
  - SE cor. Sec. S 2653.64'
  - NE cor. Sec. N 2651.72'