

APR 29 1999

## SECTION

ALLEGAN COUNTY REMONUMENTATION  
LAND CORNER RECORDATION CERTIFICATE  
Filing Requirement of Act 74, Mich. P.A. 1970For corners in  
Allegan

(County)

Located In:

Corner Code #

FILED

1/28/1999 2:44:39 PM

JOYCE A. WATTS  
REGISTER OF DEEDS  
ALLEGAN COUNTY, MICH

1. Public Land Survey

T4N R14W

A-7

T R

T R

T R

NW corner,

Section 19

Overisel Twp.

2. Property Controlling  
in Section

S T R

S T R

3. Miscellaneous

S T R

Property in Sec.

S T R

Register of Deeds Stamp &amp; File Number

4. Lot No. , Recorded Plat

5. Private Claims

I, Steve Lampen, in a field survey on December 19, 1998, do hereby certify that under requirements of P.A. 74, Michigan P.A. of 1970, the corner points mentioned in lines 1 and 2 above were in conformance with regulations and rules therefore as required in the current manual of survey instructions of the United States Department of the Interior, Bureau of Land Management or by a decree of a Court of Law and/or that the corner points mentioned in lines 3, 4 and 5 above were in conformance with the rules of the Michigan Board of Land Surveyors or by a Decree of a Court of Law; established, re-established, monumented, re-monumented, recovered, found as expressed below:

NOTE: Not more than 4 corners, all in the same town and range, may be recorded on this certificate.

A. Description of original monument and accessories and/or subsequent restoration:

A-7 Consumers Power Co. survey-1968

GLO - Britain - Brookfield 1831-1832

West between Sections 18 and 19 73.75

West boundary 66 S of post and set

Corner to Sections 18 and 19

Beech 24 N 52 E 32

Sugar 8 S 42 E 16

Found stone

A-7 to A-9 = 5273.66

A-7 to B-7 = 2238.96

Survey - VanOrder - 1986

Found 1" iron

Power pole NE 185.0

Centerline N end CMP NE 47.9

Centerline S end CMP ENE 25.63

Power pole SE 204.96

B. Description of corner evidence found and/or method applied in restoring or reestablishing corner:

A-7 Found 1" iron on East line of Section 24, Town 4 North, Range 15 West. Centerline S end CMP ENE 25.63

Power pole SE 204.96 Power pole NE 185.0 Centerline N end CMP NE 47.9

A-7 to A-9 rec. = 5273.66 meas. = 5273.75 A-7 to B-7 rec. = 2238.96 meas. = 2238.12

Replaced iron with a 3/4"x24" Allegan County Remonumentation iron and cap and accepted it as a careful and faithful perpetuation of the position of the original corner.

Traversed 2645 ft. on road.

A-7 was approved by the Allegan County Remonumentation Peer Group on December 22, 1998.

APPROVED REMONUMENTATION CORNER

P.A. 345 OF 1990

ALLEGAN COUNTY

DATE APPROVED DEC. 22, 1998

COUNTY REP. *Steve Lampen*

C. Description of monument for corner and accessories established to perpetuate locating the position of the corner:

A-7 3/4"x24" Allegan County Remonumentation iron and cap on the West line of Section 24, Town 4 North, Range 15 West

Azimuth = Michigan State Plane grid direction

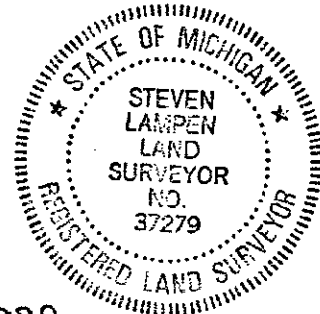
Power pole, remonumentation tag in W side 172° 19' 547.07

Power pole, remonumentation tag in W side 160° 10' 205.06

Power pole, remonumentation tag in W side 20° 59' 185.04

SE Corner garage, brick 353° 13' 1042.37

M-7, Town 4 North, Range 15 West 359° 36' 43.56

Signed by *Steven Lampen*Date *JANUARY 11, 1999*

Surveyor's Michigan License No. 37279