SECTION	LAND C		IONUMENTATION ATION CERTIFICA 174, Mich. P.A. 197		·	
For corners in	, muß 1.	equilibrilion of 710		,	S 38	
Allegan	Located In:	Corner Code#	other	2 NY 937	JAN 2	T
1. Public Land Survey	TR TR TR	DE-1 Heath Tu DE-13 Overise	2D. (Seq #5)	OF DECEMBER	ののは、日田・	
Property Controlling in Section Miscellaneous Property In Sec.	S 5 T 3N R 14 S 32 T 4N R 14 S T R S T R	<u> Heath Tu</u>		Register of De	eds Stamp &	File Number
4 Lathia Dagar	ded Diet		L			
4. Lot No, Record 5. Private Claims	ied Plat			1 B C D E	F · G · H	I J K L M
I. <u>Kirk L. Van Order</u> requirements of P.A. 74, Michigar conformance with regulations and United States Department of the Ir that the corner points mentioned it Board of Land Surveyors or by recovered, found as expressed bel	n P.A. of 1970, the corner p rules therefore as required in hterior, Bureau of Land Mana in lines 3, 4 and 5 above wer a Decree of a Court of Li	oints mentioned in lines the current manual of si gement or by a decree of a in conformance with the	1 and 2 above were in urvey instructions of the I a Court of Law and for ne rules of the Michigan	4 - 7 - 8 - 5 - 6 - 10 - 17 - 7 - 8 - 19 - 20 - 1	9 10 15 15 21 22 22 22 22 22 22 23 23 24 -	-1413-
NOTE: Not more than 2 com- on this certificate.	ers, all in the same town a	nd range, may be re∞	nded	10 30 29		2625
A Description of official con-			antaralia a c	13	ĬĬ	
Description of original more	nument and accessories	and/or subsequent re	rstoration:			
	APPROVED REMONUMENTATION CORNER P.A. 345 OF 1990 ALLEGAN COUNTY DATE APPROVED					
			•	· · · · · · · · · · · · · · · · · · ·		
B. Description of corner evidence Set standard of Section 5, T. highland on We AZ 271°14′02" AZ 271°14′02" AZ 91°14′02" AZ 91°14′02" This position monument is accorner.	Allegan County 3N., R.14W. a est side of Ra 244.68 feet 320.58 feet 2319.93 feet 2389.79 feet not establicepted as the	y witness moderate section about River from compute from compute from computer from co	nument on No. 32, T.4N., being ted position	orth and So R.14W. res E-13, E-1, on D-1, and on D-13. nment surve of the po	eyors.	This
C. Description of monument	for corner and accessor	es established to perp	petuate locating the po	sition of the corner.		
Set standard A plastic cap Nail & Remon. Nail & Remon. Nail & Remon. Top of bank	#23520) tag in NW sid tag in NE sid tag in NW sid	de 10" Red 0 de 27" Red 0 de 13" W. Oa	Dak AZ 2 Dak AZ 2 Ak AZ 2	20° 11.	32 <i>'</i> 77 <i>'</i> 27 <i>'</i> 30 <i>'</i>	ellow?
_	1/1/01	/		~		


Page 1 of 2

FORM APPROVED BY MICHGAN STATE BOARD OF PROFESSIONAL SURVEYORS, JAN. 28, 1871 REVISED MAY 14,1875 REVISED JAN., 1803 REVISED CGT., 1803

UETR 0006 PAGE 111

Surveyor's Michigan License No. 23520

Signed by

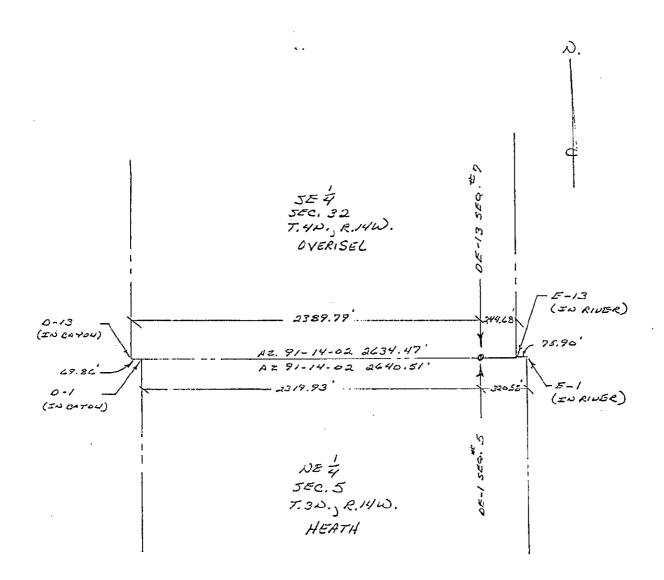

Page 2 of 2