
## APR 0 7 1998

SECTION For corners in	LAND CORN	COUNTY REHONI IER RECORDATION Froment of Act 74,	ON CERTIFICAT		
			11 01	* 30 8	
Allegan	Located in: Co	orner Code #	) JULIU -	SECURITION NAT	TI
(County)		_	北久	N 2	
1. Public Land Survey	TR TR TR TR	Heath Twp.		21 PH 1: 24  C ESTATE:  CREATERS	i M U
Property Controlling in Section     Miscellaneous Property in Sec.	S 4 T 3N R 14W S 33 4N R 14W S R R R R R R R R R R R R R R R R R R R	Heath Twp. Overisel Tw			to Shrowb on
, raperty a act			<u>L</u>	Register of Deeds Stamp & Fi	ie Number
4. Lot No , Record 5. Private Claims	ed Plat			A B C D E F G H I	J K L M
				2 6 5 4 3 3	
i, Kirk L. Van Order, requirements of P.A. 74, Michigan conformance with regulations and r United States Department of the In that the corner points mentioned is Board of Land Surveyors or by recovered, found as expressed bek	P.A. of 1970, the comer points ules therefore as required in the c terior, Bureau of Land Manageme in lines 3, 4 and 5 above were in c a Decree of a Court of Law, e	mentioned in lines 1 and surrent manual of survey ent or by a decree of a Co conformance with the rule	by state that under d 2 above were in instructions of the ourt of Law and /or es of the Michigan	4	-1112
NOTE: Not more than 2 come on this certificate.	ers, all in the same town and ra	nge, may be recorded		9	-2625
on this destinate.					
				12 31 32 33 34	_3536
				13	
A. Description of original monument and accessories and/or subsequent restoration:					
APPROVED REMONUMENTATION CORNER					
P.A. 345 OF 1990 ALLEGAN COUNTY					
			DATE APPROVED COUNTY REP	11-11-97 K.V.O.	
			COUNTY REP	<u> </u>	
		•			
B. Description of corner evidence found and/or method applied in restoring or reestablishing corner.  Set standard Allegan County witness monument on North and South lines of Section 4, T.3N., R.14W. and Section 33, T.4N., R.14W. respectively on higher lowland on East side of Rabbit River being AZ 91°14′02" 302.19 feet from computed position E-13, AZ 271°14′02" 2332.28 feet from computed position F-13, AZ 91°14′02" 226.29 feet from computed position E-1, and AZ 271°14′02" 2414.22 feet from computed position F-1.  This position not established by original government surveyors. This monument is accepted as the best available evidence of the position of the corner.  C. Description of montument for corner and accessories established to perpetuate locating the position of the corner.  Set standard Allegan County witness monument (3/4" x 36" steel rod w/yellow cap #23520)  Nail & Remon. tag in NE side 9" Ash AZ 310° 70.74′  Nail & Remon. tag in N side 22" B. Ash AZ 95° 47.87′  Nail & Remon. tag in N side 22" B. Ash AZ 95° 47.87′  Nail & Remon. tag in N side 18" Elm AZ 115° 68.60′  Nail & Remon. tag in N side 18" Elm AZ 115° 68.60′					
North edge of	Rabbit River		AZ 180°	16'+/-	
East edge of C/L steel fer	Rabbit River		AZ 270° AZ 00°	39.5′+/- 0.5′	
Signed by Sin 1	11/0/	2	Date	12-31-97	

Surveyor's Michigan License No. 23520

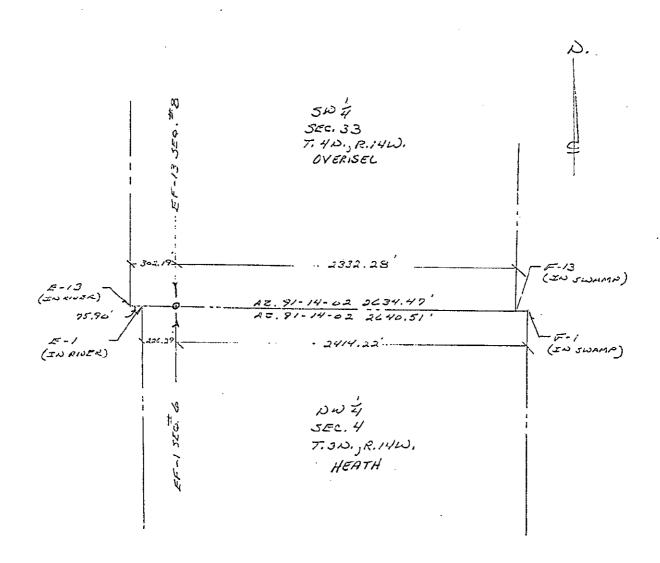

Page 2 of 2