
APR 0 7 1998

SECTION	LAND CORI	N COUNTY REHONUL NER RECORDATION uirement of Act 74, M	I CERTIFICATE	90	98	
For corners in	•		1	F- 28.2	တ	
Allegan	Located In: C	orner Code #	her	<u>K</u>	JAN	η
(County)	•	U C	10	新		=
1. Public Land Survey	T R	✓ <u>EF-1</u>	-10	650 E S	2:	
1.1 done cand carrey	Ť <u> </u>	Heath Twp. (Seq #8)		F	Ш
	TR	✓ EF-13		10 E		Ö
0 D	TR	Overisel (3	1 (#10)	** St	ի։ 2	
Property Controlling in Section	S 4 T3N R 14W S 33 T4N R 14W	<u>Heath Twp.</u> Overisel Twp		G.	,£	
3. Miscellaneous	S T R	_OVELIBEL INP	'			
Property in Sec.	S TR		1	Register of Deeds	r Stama 8 f	Eila Number
			L	Medizial of peans	S Stamp tt 1	ne Munice
A Latible Bears	ded Diet					
4. Lot No, Record 5. Private Claims	led Plat	·	_ ,,	A B C D E I	F G H I	JKLH
J. Phydie Claims	·					_
			3			
, Kirk L. Van Order	in a fold conseron. Dec.	1 10 97 do hazabu a				
requirements of P.A. 74, Michigan	n P.A. of 1970, the corner points	mentioned in lines 1 and 2	shove were in			
conformance with regulations and United States Department of the Ir	rules therefore as required in the	current manual of survey ins	tructions of the		<u> </u>	ŢŢŢŢ
that the corner points mentioned				10-1-1	0	-19-13-1
Board of Land Surveyors or by		established, re-established,	monumented,			
recovered, found as expressed bel	· ·		8	19 10 1-2	1 1	
NOTE: Not more than 2 com	ers, all in the same town and r	ange, may be recorded	9			
on this certificate.			10	30 29 -2	2827	-2625-
			11			
			12	31323	13-1-34	3536 .
A. Description of original mor			13	, L <u></u>	<u> </u>	
			קר. קרדא רו	P.A. 345 OF I P.A. 345 OF I ALLEGAN COI APPROVED	1990 UNIY 1-11-97	•
Set standard Section 4, T higher lowlan AZ 91°14′02" AZ 271°14′02" AZ 91°14′02" AZ 271°14′02" This position monument is a corner. Peer group ap C. Description of monument Set standard cap #23520) Nail & Remon. Nail & Remon. Nail & Remon.	2039.35 feet 677.06 feet 1957.41 feet 1957.41 feet 1 not establish ccepted as the b proved Nov. 11, for corner and accessories eallegan County w tag in NE side tag in W side 1 tag in N side 8 tag in S side 9 Rabbit River	witness monumed Section 33, of Rabbit Rive from computed to from computed from computed from computed from computed by origin the stavailable itness monumed itness monumed itness monumed 17" Swamp Oak S" Swamp Oak S" Swamp Oak	ent on Nor T.4N., R er being position F ed position position f i position al governm evidence locating the position at (3/4" x	.14W. resp E-1, 1 F-1, E-13, and F-13. Lent survey of the post on of the corner. 36" steel 1 25° 13. 75° 12. 80° 10. 75° 8.6 70° 25′	yors. ition o	ly on This f the
Signed by	10/19/	<i></i> -		10 41 00		
Signed by / land of	/// / /		Date /	2-31-97		
Surveyor's Michigan License	No. 23520		Date	12-31-97		

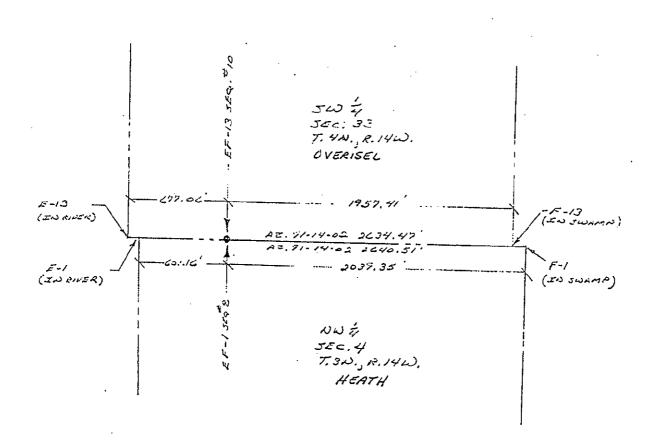

Page 2 of 2