
## SURVEY & REMONUMENTATION

APR 0.7 1998	ALLEGAN COUNTY REMON	JMENTATION		
	LAND CORNER RECORDATI	ON CERTIFICATE		
For corners in	Filing Requirement of Act 74	, Mich. P.A. 1970	, % <u>)</u> 8	
For corners in ECTION Allegan Located	la: Corner Code #	a her	JAN REGISTI	<u> </u>
1. Public Land Survey	TR EF-1 TR Heath Twp. TR EF-13	tt [] (Seq #9)	21 PH 21 CE THE STREET	
2. Property Controlling in Section S 33 3. Miscellaneous S Property in Sec. S	T R Overisel (4 Heath Tup. 1 R 14 W Overisel Two T R R 14 W Overisel Two T R	rp.	egister of Deeds Stamp & File N	Number
4 Lot No December 191-4				
4. Lot No, Recorded Plat		A	BCDFFGHII	ν,
I, Kirk L. Van Order, in a field	SUMMON Dec. 1 19 97 da baraba	1 2 3 3 y state that under 4	-6 - 5 - 4 - 3 - 2 -	12
requirements of P.A. 74, Michigan P.A. of 197 conformance with regulations and rules therefor United States Department of the Interior, Burea that the corner points mentioned in lines 3, 4 a Board of Land Surveyors or by a Decree of recovered, found as expressed below:	e as required in the current manual of survey is u of Land Management or by a decree of a Cor nd 5 above were in conformance with the sul-	nstructions of the surface of Law and for 6	16 16 15 14	13-
NOTE: Not more than 2 corners, all in the on this certificate.	same town and range, may be recorded	9	-30 -29 -28 -27 -26	24-
		11	31 32 33 34 35	36-
A. Description of original monument and				
a a company of original monament and	accessories arions subsequent restorat	ion;		
		DATE API	D REMONUMENTATION CORNER P.A. 345 OF 1990 ALLEGAN COUNTY PROVED 11-11-97 REP. K.V.O.	Ē
higher lowland on We AZ 91°14′02" 1042. AZ 271°14′02" 1597. AZ 91°14′02" 1118. AZ 271°14′02" 1515. This position not emonument is accepted corner. Peer group approved C. Description of monument for corner and Set standard Allegan cap #23520) Nail & Remon. tag in West edge of Rabbit I	14W. and Section 33, st side of Rabbit Riv. 82 feet from computed 69 feet from computed 72 feet from computed 75 feet from computed 95 feet from computed	ment on North T.4N., R.14 er being position E-1 d position E-1 position E-1 position F-1 al governmen evidence of bcating the position of at (3/4" x 36:  AZ 15° AZ 110° AZ 190° AZ 295° AZ 90°	W. respectively of the position of the following the following the following the position of the following the fol	ls ie
Surveyor's Michigan License No. 235	520			
Page 1 of 2				

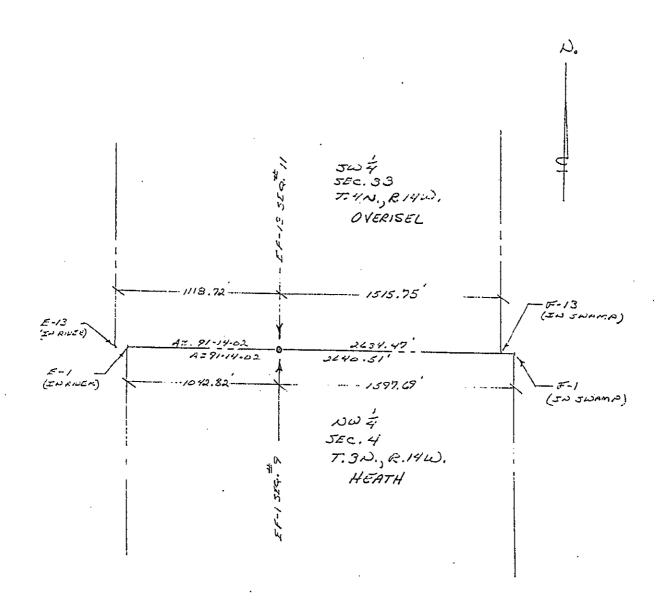

Page 2 of 2