

ALLEGAN COUNTY REMONUMENTATION
LAND CORNER RECORDATION CERTIFICATE
Filing Requirement of Act 74, Mich. P.A. 1970

For corners in
Allegan
(County)

Located In:

Corner Code #

FILED

1/28/1999 2:44:39 PM

JOYCE A. WATTS
REGISTER OF DEEDS
ALLEGAN COUNTY, MICH

Register of Deeds Stamp & File Number

1. Public Land Survey T4N R15W M-9
T R
T R
T R
2. Property Controlling S T R
in Section S T R
3. Miscellaneous S T R
Property in Sec. S T R

4. Lot No. , Recorded Plat
5. Private Claims

I, Steve Lampen, in a field survey on December 19, 1998, do hereby certify that under requirements of P.A. 74, Michigan P.A. of 1970, the corner points mentioned in lines 1 and 2 above were in conformance with regulations and rules therefore as required in the current manual of survey instructions of the United States Department of the Interior, Bureau of Land Management or by a decree of a Court of Law and/or that the corner points mentioned in lines 3, 4 and 5 above were in conformance with the rules of the Michigan Board of Land Surveyors or by a Decree of a Court of Law; established, re-established, monumented, re-monumented, recovered, found as expressed below:

NOTE: Not more than 4 corners, all in the same town and range, may be recorded on this certificate.

A. Description of original monument and accessories and/or subsequent restoration:

M-9 Consumers Power Co. 1968
GLO - Lyon-Sibley - 1831 Found stone
Set post cor. Sec.'s 24 & 25 Street sign E 21.1
Beech 16 N 36 W 44 Stump 14" SE 58.2
Beech 18 S 56 W 40 Stop sign SW 48.1
Fence post NW 40.4
6" Oak NE 53.1
M-10 S 01° 01' 05" W 2635.73
L-9 S 87° 16' 19" E 2641.03
A-9, T4N, R16W S 01° 01' 05" W 27.72

KVO field notes #82-98
June 9, 1982
Found 1" rerod in mon. box
M-10 N 00° 00' 00" E 2635.20'
L-9 N 88° 06' 24" W 2640.53

B. Description of corner evidence found and/or method applied in restoring or reestablishing corner:

M-9 Found 3/4" iron in monument box
Iron in monument box S rec. = 27.72 meas. = 27.85 M-9 to M-10 rec. = 2635.73 meas. = 2635.26
M-9 to L-9 rec. = 2641.03 meas. = 2640.64

Replaced iron with 3/4"x24" Allegan County Remonumentation iron and cap and accepted it as a careful and faithful perpetuation of the position of the original corner.

M-9 was approved by the Allegan County Remonumentation Peer Group on December 22, 1998.


APPROVED REMONUMENTATION CORNER
P.A. 345 OF 1990
ALLEGAN COUNTY
DATE APPROVED DEC. 22, 1998
COUNTY REP. *[Signature]*

C. Description of monument for corner and accessories established to perpetuate locating the position of the corner:

M-9 3/4"x24" Allegan County Remonumentation iron and cap in monument box.

Azimuth = Michigan State Plane grid direction

12" Oak, remonumentation tag in NW side	56° 21'	71.29
8" Maple, remonumentation tag in NW side	37° 08'	80.92
8" Ash, remonumentation tag in NE side	145° 52'	101.22
10" Oak, remonumentation tag in W side	159° 12'	121.03
Centerline N & S asphalt road pavement	270°	.2
Centerline asphalt road pavement towards W	180°	0.
A-9, Town 4 North, Range 14 West	179° 56'	27.86

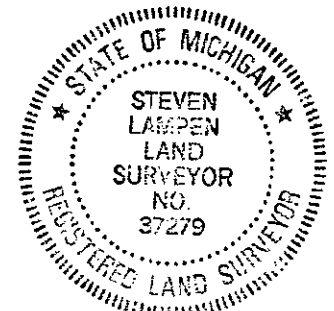

Signed by *Steven Lampen*

Date JANUARY 11, 1999

Surveyor's Michigan License No. 37279