

JAN 21 2000

LAND CORNER RECORDATION CERTIFICATE
Filing Requirement of Act 74, Mich. P.A. 1970

SECTION

For corners in

Alpena
(County)

Located In:

Corner Code #



L- 2 P- 242
11/22/1999 01:43P
Page: 1 of 1
Kathy J. Matash, Register Alpena Co., MI LDC 9.00

1. Public Land Survey

T29N R8E

H-11

T R

Sanborn Twp.

T R

T R

T R

2. Property Controlling
in Section

S

T R

3. Miscellaneous
Property in Sec.

S

T R

S

T R

Register of Deeds Stamp & File Number

4. Lot No. , Recorded Plat
5. Private Claims

I, Thomas L. Fabis, in a field survey on July 27, 1999 do hereby state that under requirements of P.A. 74, Michigan P.A. of 1970, the corner points mentioned in lines 1 and 2 above were in conformance with regulations and rules therefore as required in the current manual of survey instructions of the United States Department of the Interior, Bureau of Land Management or by a decree of a Court of Law and/or that the corner points mentioned in lines 3, 4 and 5 above were in conformance with the rules of the Michigan Board of Land Surveyors or by a Decree of a Court of Law, established, re-established, monumented, recovered, found as expressed below:

NOTE: Not more than 2 corners, all in the same town and range, may be recorded on this certificate.

	A	B	C	D	E	F	G	H	I	J	K	L	M
1													
2	6		5		4		3		2		1		
3													
4	7		8		9		10		11		12		
5													
6	18		17		16		15		14		13		
7													
8	19		20		21		22		23		24		
9													
10	30		29		28		27		26		25		
11													
12	31		32		33		34		35		36		
13													

A. Description of original monument and accessories and/or subsequent restoration:

1839: G.L.O. Survey Lewis Clason set post & referenced: Hem. 10 N46W 11, S. Maple 16 S47½E 17.
1902 & 1903: County Surveys Jos. W. McNeil post set in center of roadbed.
1997: Lewis & Lewis Survey W.O. 0403045S Wayne Lewis set 1/2" rerod w/cap and referenced.
1998: Wilcox Field Notes W.O. 98692 found 1/2" rebar 1' E. of N-S fence.

B. Description of corner evidence found and/or method applied in restoring or reestablishing corner:

1999: Found 1/2" iron rod 6' North of Scott Rd. centerline on line with freshly marked survey line to the South. Found one witness indicating that this is the same corner used by Lewis and Wilcox.

The position of this corner is compatible with county and local surveys and is accepted as a careful and faithful perpetuation of the position of the original corner.

C. Description of monument for corner and accessories established to perpetuate locating the position of the corner:

1999: Set 3" dia. alum. cap, stamped to identify the corner, over the existing 1/2" iron rod. Witnesses are:

Tag #41922 in Cor. Fe. Post N2W 24.27

Tag #31591 in Fe. Post N52E 36.45

Tag #31591 in Cor. Gate Post South 33.00

Tag #31591 in Gate Post S32W 39.10


P.A. 345 ALPENA COUNTY
PEER APPROVED 8/26/99

D.P.R. W

Signed by

Thomas L. Fabis

Surveyor's Michigan License No. 31591

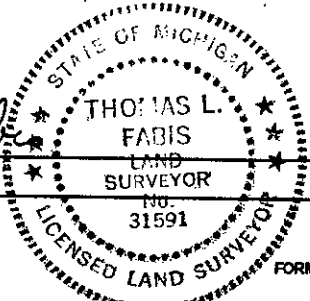

Date November 19, 1999