

LAND CORNER RECORDATION CERTIFICATE
Filing Requirement of Act 74, Mich. P.A. 1970

For corners in

Alpena
(County)

Located In:

Corner Code #

1. Public Land Survey

T____R____
T____R____

2. Property Controlling
in Section

S 2 T 30N R 7E
S 2 T 30N R 7E

2
7

3. Miscellaneous
Property in Sec.

S____T____R____
S____T____R____

Register of Deeds Stamp & File Num

4. Lot No. _____, Recorded Plat _____

5. Private Claims _____

I, Carl T. Kiiskila, in a field survey on June 23, 19 99 do hereby state that under requirements of P.A. 74, Michigan P.A. of 1970, the corner points mentioned in lines 1 and 2 above were in conformance with regulations and rules therefore as required in the current manual of survey instructions of the United States Department of the Interior, Bureau of Land Management or by a decree of a Court of Law and /or that the corner points mentioned in lines 3, 4 and 5 above were in conformance with the rules of the Michigan Board of Land Surveyors or by a Decree of a Court of Law; established, re-established, monumented, recovered, found as expressed below:

NOTE: Not more than 2 corners, all in the same town and range, may be recorded on this certificate.

	A	B	C	D	E	F	G	H	I	J	K	L	M
1													
2		6		5		4		3		2		1	
3													
4		7		8		9		10		11		12	
5													
6		18		17		16		15		14		13	
7													
8		19		20		21		22		23		24	
9													
10		30		29		28		27		26		25	
11													
12		31		32		33		34		35		36	
13													

A. Description of original monument and accessories and/or subsequent restoration:

2 - This corner position was not established during the original government survey.

7 - This corner position was not established during the original government survey.

B. Description of corner evidence found and/or method applied in restoring or reestablishing corner:

2 - Found and accepted a 1-1/4" iron pipe set by Marcus Schaaf, RLS #3104, c. 1940.

7 - Found and accepted a 1-1/4" iron pipe set by Marcus Schaaf, RLS #3104, c. 1940.

C. Description of monument for corner and accessories established to perpetuate locating the position of the corner:

2 - Found 1-1/4" iron pipe. Set a carsonite marker post.

Wit: Set nail in 6" Maple clump N 16° W 14.18'

Set nail in 3" Maple N 40° E 23.21'

Set nail in 6" Maple S 28° E 16.88'

Set nail in 3" White Birch S 59° W 30.55'

Carsonite post North 2'

In centerline of east-west and south trail roads.

7 - Found 1-1/4" iron pipe. Set a carsonite marker post.

Wit: Set nail in 6" White Birch S 30° W 17.38'

Set nail in 6" White Birch N 68° W 13.48'

Set nail in 4" Ash N 61° E 26.39'


Set nail in 3" Spruce S 55° E 24.73'

Centerline of north-south trail road East 6'

Carsonite post East 20'

Signed by Carl T. Kiiskila

Surveyor's Michigan License No. 33981

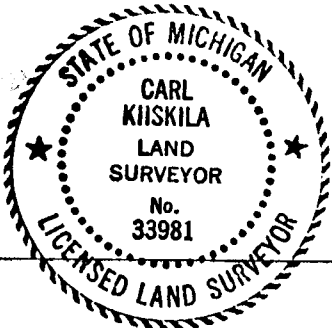

Date 8-12-99