

SURVEY &
REMONUMENTATION

LIBER 002 TAB 173

FEB 17 1998 LAND CORNER RECORDATION CERTIFICATE

COMMISSION FILING REQUIREMENT OF ACT 74, MICH. P.A. 1970

FOR CORNERS OF--	LOCATED IN--	CORNER CODE NUMBER
1. PUBLIC LAND SURVEY <u>24</u> T. <u>30</u> N. <u>8</u> E. W.		<u>M-8</u>
2. PROPERTY CONTROLLING IN SECTION _____, T. _____ S., R. _____ E. W.		
3. MISCELLANEOUS PROPERTY IN SECTION _____, T. _____ S., R. _____ E. W.		
4. LOT NO. _____, RECORDED PLAT _____		
5. PRIVATE CLAIMS _____		

ANTRIM COUNTY
MICHIGAN
RECEIVED FOR RECORD
93 DEC 14 AM 10:53
Wanda R. Conway
REGISTER OF DEEDS

REGISTER OF DEEDS STAMP AND
FILING NUMBER

I, Terry B. Smith, do hereby certify that under requirements of P.A. 74, Michigan P.A. of 1970, the corner points mentioned in lines 1 and 2 above were, in a field survey on Dec. 6, 19 93, established, re-established, monumented, re-monumented, recovered or restored as expressed below and in conformance with regulations and rules therefore as required in the current manual of survey instructions of the United States Department of the Interior, Bureau of Land Management or by a decree of a court of law. Furthermore, that the corner points mentioned in lines 3, 4 and 5 above were, in a field survey on Dec. 6, 19 93, found, recovered, restored, established or re-established as expressed below and in conformance with the rules of the Michigan State Board of Registration for Land Surveyors or, by a Decree of a Court of law:

A. Description of original monument and accessories and/or subsequent restoration:

1855
Elm 40 S45W 18
Hemlock 30 N78E 7

B. Description of corner evidence found and/or method applied in restoring or re-establishing corner:

Corner recorded in Liber 199 page 237
Found existing monument as described in
Survey by R. C. Dunn 9-16-72 recorded in Liber 199
pages 468 and 469.

Peer group approval to set

C. Description of monument for corner and accessories established to perpetuate locating the position of the corner:

Set Antrim County Monument
40" Elm S30°E 80.65
Utility pole N58°29'W 39.54
24" Maple N55°09'E 45.85

SIGNED BY Terry B. Smith DATE _____

SURVEYOR'S MICHIGAN REGISTRATION NO. 25873


FOR STATE AND UNITED STATES AGENCIES:

SIGNED BY _____ DATE _____

CHIEF OF SURVEY PARTY

APPROVED AND SIGNED BY _____ DATE _____

MICHIGAN REGISTERED LAND SURVEYOR

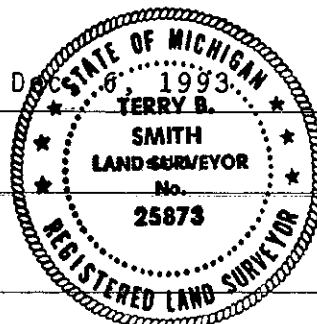

(SEAL)

SURVEYOR'S MICHIGAN REGISTRATION NO. _____