

DEC 4 2 24 PM '96

LAND CORNER RECORDATION CERTIFICATE
Filing Requirement of Act 74, Mich. P.A. 1970

Wanda R. Oleson

For corners in

REGISTER OF DEEDS

Located In: _____ Corner Code # _____

(County) _____

1. Public Land Survey T 30NR 9W Meander #1
T R
T R
T R
T R

2. Property Controlling S T R
in Section S T R

3. Miscellaneous S T R
Property in Sec. S T R

4. Lot No. _____, Recorded Plat _____

5. Private Claims _____

Register of Deeds Stamp & File Number

I, Terry B. Smith, in a field survey on Nov. 18, 1996 do hereby state that under requirements of P.A. 74, Michigan P.A. of 1970, the corner points mentioned in lines 1 and 2 above were in conformance with regulations and rules therefore as required in the current manual of survey instructions of the United States Department of the Interior, Bureau of Land Management or by a decree of a Court of Law and/or that the corner points mentioned in lines 3, 4 and 5 above were in conformance with the rules of the Michigan Board of Land Surveyors or by a Decree of a Court of Law; established, re-established, monumented, recovered, found as expressed below:

NOTE: Not more than 2 corners, all in the same town and range, may be recorded on this certificate.

	A	B	C	D	E	F	G	H	I	J	K	L	M
1													
2		6		5		4		3		2		1	
3													
4		7		8		9		10		11		12	
5													
6		18		17		16		15		14		13	
7													
8		19		20		21		22		23		24	
9													
10		30		29		28		27		26		25	
11													
12		31		32		33		34		35		36	
13													

A. Description of original monument and accessories and/or subsequent restoration:

Aug. 25, 1855
Meander #1
GLO Did Not Establish


B. Description of corner evidence found and/or method applied in restoring or reestablishing corner:

Oct 23, 1958 recorded plat of North Golden Beach
Liber 2 of plats page 99

Corner found -- concrete monument per plat

C. Description of monument for corner and accessories established to perpetuate locating the position of the corner:

Set Antrim County Monument
8" R. Pine N30W 8.70
14" R. Pine N80E 9.35
6" Cedar S70E 14.70
6" Cedar S05E 2.75

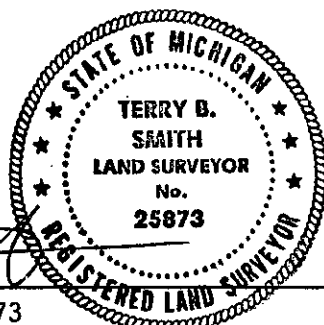

Ratified by Peer Group
in accordance with
PO 345.

Antrim county Chairman

Arthur L. Lennox

Nov. 26, 1996

Signed by Terry B. Smith
Surveyor's Michigan License No. 25873

Date Dec 3, 1996

002 335

99