

DEC 4 2 24 PM '96

LAND CORNER RECORDATION CERTIFICATE
Filing Requirement of Act 74, Mich. P.A. 1970

Wanda R. Conway

REGISTER OF DEEDS

For corners in

Located In:

Corner Code #

(County)

1. Public Land Survey

T 30NR 9W

Meander #3

T R

T R

T R

T R

2. Property Controlling
in Section

S T R

S T R

3. Miscellaneous
Property in Sec.

S T R

S T R

4. Lot No. , Recorded Plat

5. Private Claims

I, Terry B. Smith, in a field survey on Nov. 18, 1996 do hereby state that under requirements of P.A. 74, Michigan P.A. of 1970, the corner points mentioned in lines 1 and 2 above were in conformance with regulations and rules therefore as required in the current manual of survey instructions of the United States Department of the Interior, Bureau of Land Management or by a decree of a Court of Law and/or that the corner points mentioned in lines 3, 4 and 5 above were in conformance with the rules of the Michigan Board of Land Surveyors or by a Decree of a Court of Law; established, re-established, monumented, recovered, found as expressed below:

NOTE: Not more than 2 corners, all in the same town and range, may be recorded on this certificate.

A. Description of original monument and accessories and/or subsequent restoration:

Aug. 25, 1855

Meander post

W. Pine N57E 14

W. Pine S40E 20

30.28 chains west from section corner at intersection of shore GT Bay

B. Description of corner evidence found and/or method applied in restoring or reestablishing corner:

Jan 23, 1954 recorded plat of Golden Beach

Liber 2 of plats page 74

Corner lost -- reestablished using plat of Golden Beach

C. Description of monument for corner and accessories established to perpetuate locating the position of the corner:

Antrim County Monument
UP S40E 52.

8" W. Pine N20E 24.80

12" Poplar N40E 38.50

16" W. Pine S40W 46.60

Shore of GT Bay 88.5

Ratified by Peer Group
in accordance with
PO 345.

Antrim County Chairman


Arthur L. Lennox

Arthur L. Lennox

Nov. 26, 1996

Signed by *T.B. Smith*

Surveyor's Michigan License No. 25873

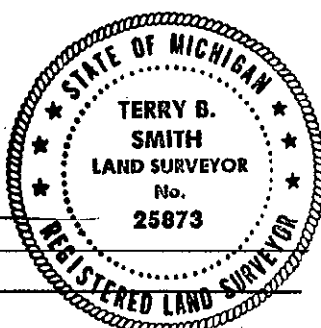

Date Dec 3, 1996

100

002 336