

Dec 4 2 24 PM '96

LAND CORNER RECORDATION CERTIFICATE
Filing Requirement of Act 74, Mich. P.A. 1970

Wanda R. Conway

For corners in

REGISTER OF DEEDS

	Located In:	Corner Code #
1. Public Land Survey	T 30N R 9W	L-1
	T R	
	T R	
	T R	
2. Property Controlling in Section	S T R	
	S T R	
3. Miscellaneous Property in Sec.	S T R	
	S T R	

Register of Deeds Stamp & File Number

4. Lot No. _____, Recorded Plat _____
5. Private Claims _____

I, Terry B. Smith, in a field survey on Nov. 18, 1996 do hereby state that under requirements of P.A. 74, Michigan P.A. of 1970, the corner points mentioned in lines 1 and 2 above were in conformance with regulations and rules therefore as required in the current manual of survey instructions of the United States Department of the Interior, Bureau of Land Management or by a decree of a Court of Law and/or that the corner points mentioned in lines 3, 4 and 5 above were in conformance with the rules of the Michigan Board of Land Surveyors or by a Decree of a Court of Law; established, re-established, monumented, recovered, found as expressed below:

NOTE: Not more than 2 corners, all in the same town and range, may be recorded on this certificate.

	A	B	C	D	E	F	G	H	I	J	K	L	M
1													
2		6		5		4		3		2		1	
3													
4		7		8		9		10		11		12	
5													
6		18		17		16		15		14		13	
7													
8		19		20		21		22		23		24	
9													
10		30		29		28		27		26		25	
11													
12		31		32		33		34		35		36	
13													

A. Description of original monument and accessories and/or subsequent restoration:


GLO Ran North line of Township no mention of corners
in Section 1 notes pertain to Section 36, T31N, R9W

B. Description of corner evidence found and/or method applied in restoring or reestablishing corner:

1975 Liber 224 page 826 survey by J. Fletcher
1979 G. De La Meter Survey of correction line

C. Description of monument for corner and accessories established to perpetuate locating the position of the corner:

Set Antrim County Monument
4" Poplar S40W 25.85
1/2" Iron South 33.00
36" Maple S70E 90.60
30" Maple N55W 78.20

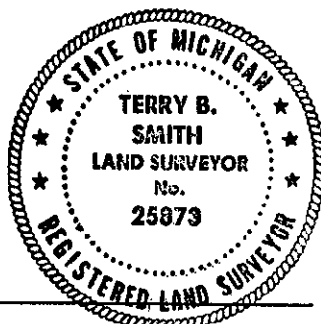

Ratified by Peer Group
in accordance with
PO 345.

Antrim County Chairman

Arthur L. Lennox
Arthur L. Lennox
Nov. 26, 1996

Signed by *Terry B. Smith* 25873
Surveyor's Michigan License No. _____

Date Dec. 3, 1996

002 325