

DEC 4 2 23 PM '96

LAND CORNER RECORDATION CERTIFICATE
Filing Requirement of Act 74, Mich. P.A. 1970

For corners in

Located In:

Corner Code #

(County)

1. Public Land Survey

T 30N R 9W

M-2

T R

T R

T R

T R

2. Property Controlling
in Section

S

T R

S

T R

3. Miscellaneous
Property in Sec.

S

T R

S

T R

REGISTER OF DEEDS

Register of Deeds Stamp & File Number

4. Lot No. , Recorded Plat

5. Private Claims

I, Terry B. Smith in a field survey on Nov. 18, 1996 do hereby state that under requirements of P.A. 74, Michigan P.A. of 1970, the corner points mentioned in lines 1 and 2 above were in conformance with regulations and rules therefore as required in the current manual of survey instructions of the United States Department of the Interior, Bureau of Land Management or by a decree of a Court of Law and/or that the corner points mentioned in lines 3, 4 and 5 above were in conformance with the rules of the Michigan Board of Land Surveyors or by a Decree of a Court of Law; established, re-established, monumented, recovered, found as expressed below:

NOTE: Not more than 2 corners, all in the same town and range, may be recorded on this certificate.

	A	B	C	D	E	F	G	H	I	J	K	L	M
1													
2	6		5		4		3		2		1		
3													
4	7		8		9		10		11		12		
5													
6	18		17		16		15		14		13		
7													
8	19		20		21		22		23		24		
9													
10	30		29		28		27		26		25		
11													
12	31		32		33		34		35		36		
13													

A. Description of original monument and accessories and/or subsequent restoration:


GL0 Ran North on East side of Sec 1
set Beech post for $\frac{1}{4}$ sec. corner @ 40.00
Beech 12 N28W 25
Sugar 8 S48E 27

B. Description of corner evidence found and/or method applied in restoring or reestablishing corner:

1885 County Surveyor F. Church survey for James Peckham
 $\frac{1}{4}$ section corner gone -- witnesses also
1948 H. Botsford survey
1947 Plat of West Pointe Shores
1991 survey by Lennox & Assoc.
1996 found pinch pipe at plat distance

C. Description of monument for corner and accessories established to perpetuate locating the position of the corner:

Set Antrim County Monument
10" Birch N33E 28.25
12" Maple N55W 15.15
12" Db1 Maple S17W 42.70
6" Basswood S40E 23.54

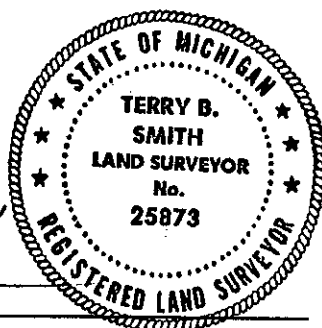

Ratified by Peer Group
in accordance with
PO 345.

Antrim County Chairman

Arthur L. Lennox
Nov. 26, 1996

Signed by T.B. Smith
Surveyor's Michigan License No. 25873

Date Dec. 3, 1996

85