

ANTRIM COUNTY  
MICHIGAN  
RECEIVED FOR RECORD  
DEC 4 2 23 PM '96  
Wanda Q. Denney  
REGISTER OF DEEDS.

LAND CORNER RECORDATION CERTIFICATE  
Filing Requirement of Act 74, Mich. P.A. 1970

For corners in

_____	Located In:	Corner Code #
(County)		
1. Public Land Survey	T 30NB 9W	M-4
	T R	
	T R	
	T R	
2. Property Controlling in Section	S T R	
	S T R	
3. Miscellaneous Property in Sec.	S T R	
	S T R	

Register of Deeds Stamp & File Number

4. Lot No. \_\_\_\_\_, Recorded Plat \_\_\_\_\_  
5. Private Claims \_\_\_\_\_

I, Terry B. Smith, in a field survey on Nov. 18, 1996 do hereby state that under requirements of P.A. 74, Michigan P.A. of 1970, the corner points mentioned in lines 1 and 2 above were in conformance with regulations and rules therefore as required in the current manual of survey instructions of the United States Department of the Interior, Bureau of Land Management or by a decree of a Court of Law and/or that the corner points mentioned in lines 3, 4 and 5 above were in conformance with the rules of the Michigan Board of Land Surveyors or by a Decree of a Court of Law; established, re-established, monumented, recovered, found as expressed below:

NOTE: Not more than 2 corners, all in the same town and range, may be recorded on this certificate.

	A	B	C	D	E	F	G	H	I	J	K	L	M
1													
2	6		5		4		3		2		1		
3													
4	7		8		9		10		11		12		
5													
6	18		17		16		15		14		13		
7													
8	19		20		21		22		23		24		
9													
10	30		29		28		27		26		25		
11													
12	31		32		33		34		35		36		
13													

A. Description of original monument and accessories and/or subsequent restoration:


GL0 Ran North on East side of Sec 12  
set Hemlock post for 1/4 sec. corner @ 40.00  
Beech 8 S24W 27  
Hem 36 N25E 62

B. Description of corner evidence found and/or method applied in restoring or reestablishing corner:

1951 S. Walker survey  
1975 survey by Lennox & Assoc  
1976 survey by Lennox & Assoc  
1988 LCRC Liber 002 page 51  
survey by G. Avendt  
1996 found "T" iron & witnesses

C. Description of monument for corner and accessories established to perpetuate locating the position of the corner:

Set Antrim County Monument  
10" Birch N85E 27.50  
UP S25W 48.35  
16" Db1-Birch S55W 47.90  
UP S20W 84.10

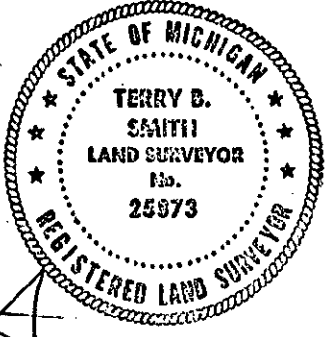

Ratified by Peer Group  
in accordance with  
PO 345.

Antrim County Chairman

*Arthur L. Lennox*

Arthur L. Lennox  
Nov. 26, 1996

Signed by *Terry B. Smith*

Surveyor's Michigan License No. \_\_\_\_\_

25873  
002 321

Date \_\_\_\_\_

Dec. 3, 1996

84