

1995 ALPENA COUNTY REMONUMENTATION CORNER

LAND CORNER RECORDATION CERTIFICATE  
Filing Requirement of Act 74, Mich. P.A. 1970

JUN 16 2 53 PM '95

*Springer A. Johnston*  
REGISTER OF DEEDS

For corners in

Alpena  
(County)

Located In:

Corner Code ##

1. Public Land Survey

T 32N R 7E

G-12.75 (M.P.)

T R

Maple Ridge Twp.

T R

T R

*Other #33*

2. Property Controlling  
in Section

S T R

S T R

3. Miscellaneous

S T R

Property in Sec.

S T R

Register of Deeds Stamp & File Number

4. Lot No. , Recorded Plat

5. Private Claims

	A	B	C	D	E	F	G	H	I	J	K	L	M
2	6		5		4		3		2		1		
3													
4	7		8		9		10		11		12		
5													
6	18		17		16		15		14		13		
7													
8	19		20		21		22		23		24		
9													
10	30		29		28		27		26		25		
11													
12	31		32		33		34		35		36		
13													

M.P.

Thomas L. Fabis in a field survey on April 7, 19 95  
do hereby certify that under requirements of P.A. 74, Michigan P.A. of 1970, the corner points mentioned  
in lines 1 and 2 above were in conformance with regulations and rules therefore as required in the  
current manual of survey instructions of the United States Department of the Interior, Bureau of Land  
Management or by a decree of a Court of Law and/or that the corner points mentioned in lines 3, 4 and 5  
above were in conformance with the rules of the Michigan Board of Land Surveyors or by a Decree of a  
Court of Law; established, re-established, monumented, re-monumented, recovered, found as  
expressed below:

NOTE: Not more than 4 corners, all in the same town and range, may be recorded  
on this certificate.

A. Description of original monument and accessories and/or subsequent restoration:

Note: This corner was not set during the G.L.O. Surveys.

1890: County Survey by W.H. LeRoy - measures along Section line but does not  
set M.P.

1959: Dietz Park Subdivision Survey by Frank A. Deschamps - Makes tie to Section  
line but does not set meander post.

1986: Survey W.O. 4-243 by Earl T. Lewis - Sets concrete monument meander post.

1993: Road Centerline Survey by Thomas L. Fabis - Makes tie to Section line but  
not to M.P.

B. Description of corner evidence found and/or method applied in restoring or reestablishing corner:

1995: Found concrete monument capped P.S. 27452 at end of very old fence line on  
bank of Flooded Thunder Bay River, (now, known as Lake Winyah) as per 1986  
Survey by Earl T. Lewis W.O. 4-243. This corner position establishes  
the bearing of the Section line between Sections 33 and 34 in the lower  
half and is compatible with county and local surveys. Its position is  
accepted as a careful and faithful determination of the position of the  
corner.

REMONUMENTATION

AUG 23 1995

COMMISSION

C. Description of monument for corner and accessories established to perpetuate locating the position of the corner:

1995: Set 3" dia. aluminum cap, stamped to identify the corner, on top of  
existing concrete monument.

Established witnesses are:

12" Hemlock - N70W - 7.41'

6" Cedar - S15E - 3.77'

6" Hemlock - N35E - 7.97'

5" Cedar - S70W - 11.60'


P.A. 345 ALPENA COUNTY  
PEER APPROVED

*May 18 1991*  
*Det. B. Lee*

Signed by

*Thomas L. Fabis*

Surveyor's Michigan License No. 31591

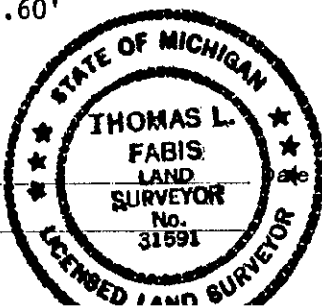

*June 12, 1995*