

NOV 16 1998

P.A. 345 ALPENA COUNTY
PEER APPROVED 8/10/98
Det. B. Lee

1998 Alpena County Remonumentation Corner
LAND CORNER RECORDATION CERTIFICATE
Filing Requirement of Act 74, Mich. P.A. 1970

SECTION
000002 Page 0146

For corners in

<u>Alpena</u> (County)	Located in:	Corner Code #
1. Public Land Survey	T <u>32N</u> R <u>7E</u>	<u>M-3</u> ✓
	T <u>32N</u> R <u>8E</u>	<u>A-3</u> ✓
	T <u> </u> R <u> </u>	
	T <u> </u> R <u> </u>	
2. Property Controlling in Section	S <u> </u> T <u> </u> R <u> </u>	
	S <u> </u> T <u> </u> R <u> </u>	
3. Miscellaneous Property in Sec.	S <u> </u> T <u> </u> R <u> </u>	
	S <u> </u> T <u> </u> R <u> </u>	

STATE OF MICHIGAN
County of Alpena
Recorded
08-20-1998 09:18:29
Kathy J. Matash
REGISTER OF DEEDS

Register of Deeds Stamp & File Number

4. Lot No. , Recorded Plat
5. Private Claims

I, Daniel T. Kibbe, in a field survey on March 17, 1998 do hereby state that under requirements of P.A. 74, Michigan P.A. of 1970, the corner points mentioned in lines 1 and 2 above were in conformance with regulations and rules therefore as required in the current manual of survey instructions of the United States Department of the Interior, Bureau of Land Management or by a decree of a Court of Law and /or that the corner points mentioned in lines 3, 4 and 5 above were in conformance with the rules of the Michigan Board of Land Surveyors or by a Decree of a Court of Law; established, re-established, monumented, recovered, found as expressed below:

NOTE: Not more than 2 corners, all in the same town and range, may be recorded on this certificate.

	A	B	C	D	E	F	G	H	I	J	K	L	M
1													
2	6			5			4		3		2		1
3													
4	7			8			9		10		11		12
5													
6	18			17			16		15		14		13
7													
8	19			20			21		22		23		24
9													
10	30			29			28		27		26		25
11													
12	31			32			33		34		35		36
13													

A. Description of original monument and accessories and/or subsequent restoration:

- 1857: GLO Survey by Josiah Knaver-old section corner reestablished; referenced: Hemlock 24-N35W-15 links
Hemlock 40-S58W-20 links
1890: County Survey by William H. LeRoy-found the stumps of old NBT's. Set cedar stake 3" sq.; referenced: W. Pine stump
28-S49E-88 NWT
1892: County Survey by William H. LeRoy-ran from previously established corner
1981: Survey by Duane R. MacNeil-set 3/4" pipe; referenced: Fence Post-N10W-35.60'/P.Pole-N25E-53.19'/Fence Post-S35W-49.84'


B. Description of corner evidence found and/or method applied in restoring or reestablishing corner:

- 1998: Remon. Survey by Daniel T. Kibbe-found 1" pipe bent to North set spike on South side of pipe. CL of road to the South. 4' South of CL road to West. 8' South of fence row to the East.

This corner position is compatible with county & local surveys. This corner position is accepted as a careful and faithful perpetuation of the position of the original corner.

C. Description of monument for corner and accessories established to perpetuate locating the position of the corner:

- 1998: Placed 3" Alpena County cap stamped to identify the corner over 1/2" iron rod.
Referenced:
Fd. tag in P.Pole #22435-N45E-52.76'
Center of steel fence post-S86E-64.80'
Set tag in fence post-N50W-70.13'
Set tag in fence post-S85W-79.49'

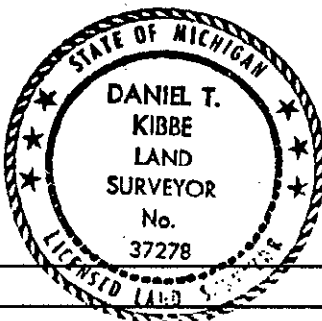

Signed by Daniel T. Kibbe
Surveyor's Michigan License No. 37278

Date August 14, 1998