

DEC 10 1993

LIBER

1 PAGE 266

007565

RECORDED
ALPENA COUNTY MI.

1993 ~~ADMISSION~~ remonumentation Corner

LAND CORNER RECORDATION CERTIFICATE

Filing Requirement of Act 74, Mich. P.A. 1970

Dec 1 3 16 PM '93

Myriam A. Johnston
REGISTER OF DEEDS

For corners in

Alpena

(County)

Located In:

Corner Code #

- | | | | | | |
|-------------------------|---|------------|---|-----------|----------------------------|
| 1. Public Land Survey | T | <u>32N</u> | R | <u>8E</u> | A-8 (W $\frac{1}{2}$, 19) |
| | T | | R | | (Alpena Twp.) |
| | T | | R | | |
| | T | | R | | |
| 2. Property Controlling | S | | T | R | |
| in Section | S | | T | R | |
| 3. Miscellaneous | S | | T | R | |
| Property in Sec. | S | | T | R | |

Register of Deeds Stamp & File Number

4. Lot No. _____, Recorded Plat _____
5. Private Claims _____

I, Thomas L. Fabis in a field survey on August 19, 19 93, do hereby certify that under requirements of P.A. 74, Michigan P.A. of 1970, the corner points mentioned in lines 1 and 2 above were in conformance with regulations and rules therefore as required in the current manual of survey instructions of the United States Department of the Interior, Bureau of Land Management or by a decree of a Court of Law and/or that the corner points mentioned in lines 3, 4 and 5 above were in conformance with the rules of the Michigan Board of Land Surveyors or by a Decree of a Court of Law; established, re-established, monumented, re-monumented, recovered, found as expressed below:

NOTE: Not more than 4 corners, all in the same town and range, may be recorded on this certificate.

	A	B	C	D	E	F	G	H	I	J	K	L	M
2	6	5	4	3	2	1							
3													
4	7	8	9	10	11	12							
5													
6	18	17	16	15	14	13							
7													
8	19	20	21	22	23	24							
9													
10	30	29	28	27	26	25							
11													
12	31	32	33	34	35	36							
13													

A. Description of original monument and accessories and/or subsequent restoration:


- 1855: G.L.O. Resurvey by Josiah Knauer - set post (Beech 24 S73W 35, Beech 18 N65W 25).
- 1893: County survey by Fred A. Rice - Found stone in Road centerline and set new N.B.T. (Beech 9 N70 $\frac{1}{2}$ W 30).
- 1979: Recorded surveys Liber 2 Pages 293 and 294 by Duane R. MacNeill - Found 2" pipe (S50°W - 40.05' - 6" Beech, S85°W - 34.48' - Fe. Po., N50°W - 40.14' - Maple)

B. Description of corner evidence found and/or method applied in restoring or reestablishing corner:

- 1993: Found 2" pipe and 2 witnesses as per Recorded survey by Duane R. MacNeill and is accepted as a careful and faithful perpetuation of the position of the original corner.
- Also, found 2 other existing witnesses tagged R.L.S. #22435 (S30°W - 39.25' - 10" Basswood, N65°E - 101.10' - 8" W. Pine).
- Distance between this corner and the S.W. Corner of Section 19 checks proportionately with 1893 County Survey by Fred A. Rice.

C. Description of monument for corner and accessories established to perpetuate locating the position of the corner:

- 1993: Removed existing corner material and set $\frac{1}{2}$ " iron rod with 3" aluminum cap stamped to identify the corner.
- Reestablished witnesses are:
- Exis. tag #22435 in 10" Basswood - S30°W - 39.25'
- Set tag #31591 in 10" Maple - N60°W - 41.57'
- Exis. tag #22435 in 8" W. Pine - N65°E - 101.10'
- Set tag #31591 in P. Pole - N25°E - 107.16'

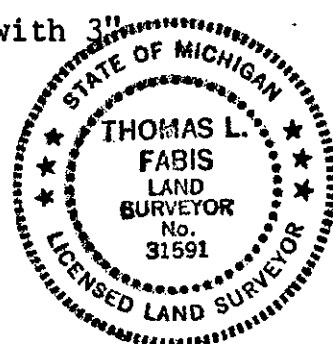

Signed by Thomas L. Fabis

Date November 22, 1993

Surveyor's Michigan License No. 31591