

LIBER

1 PAGE 281

1993 ALPENA COUNTY REMONUMENTATION CORNER

RECORDED
ALPENA COUNTY MI.LAND CORNER RECORDATION CERTIFICATE
Filing Requirement of Act 74, Mich. P.A. 1970

For corners in

Alpena
(County)

Located In:

Corner Code #

Dec 16 10 19 AM '93

Maureen A. Johnston
REGISTER OF DEEDS

- | | | | | | |
|------------------------------------|---|------------|---|-----------|--------------|
| 1. Public Land Survey | T | <u>32N</u> | R | <u>8E</u> | <u>I - 8</u> |
| | T | | R | | |
| | T | | R | | |
| | T | | R | | |
| 2. Property Controlling in Section | S | | T | R | |
| | S | | T | R | |
| 3. Miscellaneous | S | | T | R | |
| Property in Sec. | S | | T | R | |

Register of Deeds Stamp & File Number

4. Lot No. _____, Recorded Plat _____
5. Private Claims _____

I, Duane R. MacNeill, in a field survey on July 23, 19 93, do hereby certify that under requirements of P.A. 74, Michigan P.A. of 1970, the corner points mentioned in lines 1 and 2 above were in conformance with regulations and rules therefore as required in the current manual of survey instructions of the United States Department of the Interior, Bureau of Land Management or by a decree of a Court of Law and/or that the corner points mentioned in lines 3, 4 and 5 above were in conformance with the rules of the Michigan Board of Land Surveyors or by a Decree of a Court of Law; established, re-established, monumented, re-monumented, recovered, found as expressed below;

NOTE: Not more than 4 corners, all in the same town and range, may be recorded on this certificate.

- A. Description of original monument and accessories and/or subsequent restoration:

1855 - Cedar PostWitnesses:

Cedar 10 S 54 1/2° W 22

Cedar 14 N 49° E 14

1901 - Cedar Stake found and replaced by Cedar stake by County Surveyor Leroy. No original evidence found. No witnesses given.

1973 - Corner Recordation form by James Scott reports found 1" pipe. No witness given. Pipe has been used in subsequent surveys.

- B. Description of corner evidence found and/or method applied in restoring or reestablishing corner:

1978 - Recorded survey by D.R. MacNeill & Associates shows found 1" pipe and witnesses:

N 40° E	38.06'	P.P
S 30° W	46.43'	4" Aspen
N 80° W	76°07'	P.P

1" pipe above found during remonumentation field work.

- C. Description of monument for corner and accessories established to perpetuate locating the position of the corner:

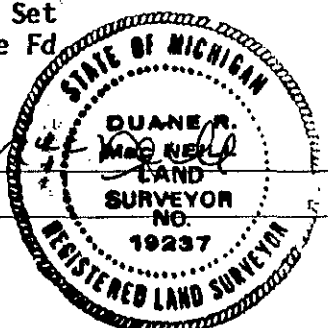
1" pipe driven to approx. 9" below surface of roadway; 1/2" rerod was driven inside pipe and capped with appropriately stamped Alpena County Remonumentation Aluminum Cap. (Cap rests approx. 6" below road surface)

Witnesses:

N 54° E	37.98'	Tel. Pole Fd.
S 88° E	60.47'	10" Maple Fd. cap #22435
N 30° W	61.91'	6" Cedar Set
N 78° W	76.09'	Power Pole Fd.

Witnesses were freshened as necessary and nails replaced with duplex nails bearing a brass washer stamped License #19237

Signed by *Duane R. MacNeill*
Surveyor's Michigan License No. 19237

Date December 6, 1993