

JAN 27 2000

SECTION

LAND CORNER RECORDATION CERTIFICATE
Filing Requirement of Act 74, Mich. P.A. 1970

Liber 000003 Page 0094

For corners in

ANTRIM

(County)

Located in:

Corner Code #

1. Public Land Survey

T 29NR 8W

G-8

T R

T R

T R

2. Property Controlling
in Section

S

T R

S

T R

3. Miscellaneous
Property in Sec.

S

T R

S

T R

ANTRIM COUNTY MI.
Register of Deeds
Recorded


12-20-1999 10:11:43

Manda R. Conway
REGISTER OF DEEDS

Register of Deeds Stamp & File Number

4. Lot No. , Recorded Plat

5. Private Claims

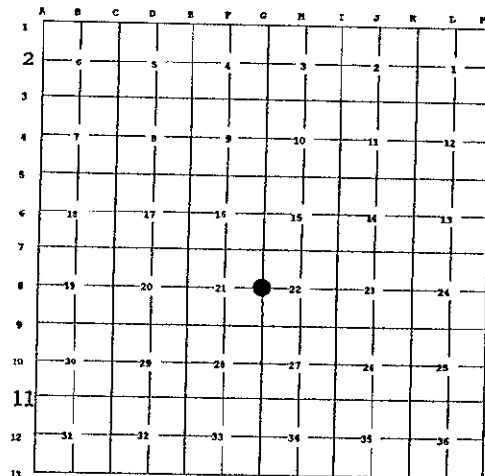

I, NEIL L. WAY, in a field survey on 12-15, 1999 do hereby state that under requirements of P.A. 74, Michigan P.A. of 1970, the corner points mentioned in lines 1 and 2 above were in conformance with regulations and rules therefore as required in the current manual of survey instructions of the United States Department of the Interior, Bureau of Land Management or by a decree of a Court of Law and for that the corner points mentioned in lines 3, 4 and 5 above were in conformance with the rules of the Michigan Board of Land Surveyors or by a Decree of a Court of Law; established, re-established, monumented, recovered, found as expressed below:

NOTE: Not more than 2 corners, all in the same town and range, may be recorded on this certificate.

A. Description of original monument and accessories and/or subsequent restoration:

G-8 GLO SET POST 1850, SUGAR 10 N87W 9, BEECH 18 S7E 50

CAUKIN USED COR 1925 NO DESC OR WIT, AUSTIN USED COR 1959 NO DESC OR WIT, ERICKSON USED COR 1960 NO DESC OR WIT, OSTLING USED AND WIT COR OCT 25, 1972, LENNOX USED AND WIT COR IN 1978, JONES USED AND WIT COR 89, 91, 93.

NEIL L. WAY SET 1/2" IRON ROD AND CAP #28432 ON SECTION LINE FROM LENNOX AND JONES CERT'S OF RECORD. JUNE 2, 1998.

B. Description of corner evidence found and/or method applied in restoring or reestablishing corner:


G-8 FOUND 1/2" IRON ROD AND CAP #28432 ON OLD FENCE EAST AND WEST 1' EAST OF CENTERLINE N-S RD. AS NOTED IN "A" ABOVE.

C. Description of monument for corner and accessories established to perpetuate locating the position of the corner:

G-8 REMOVED CORNER AND REPLACED WITH COUNTY MONUMENT AND MONUMENT BOX.

N 20 E 89.19' P. POLE
N 52 W 68.23' WALNUT 24"
S 15 W 213.53' P. POLE
S 70 E 70.80' ELM 6"

Ratified by Peer Group
In accordance with
P.O. 345
Antrim Co. Chairman

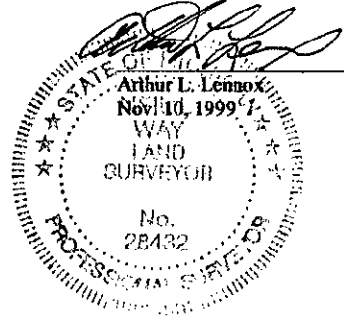

Signed by

Date DEC. 15, 1999

Surveyor's Michigan License No. 28432