

JAN 23 2001

Liber **000003** Page **0135**

SECTION

LAND CORNER RECORDATION CERTIFICATE
Filing Requirement of Act 74, Mich. P.A. 1970

For corners in

<u>Antrim</u> (County)	Located In:	<u>Echo</u> Corner Code #
1. Public Land Survey	<u>N 1/4 14</u>	<u>T31N R7W</u> <u>J-5</u>
		<u>T R</u>
		<u>T R</u>
		<u>T R</u>
2. Property Controlling in Section	<u>S</u>	<u>T R</u>
	<u>S</u>	<u>T R</u>
3. Miscellaneous Property in Sec.	<u>S</u>	<u>T R</u>
	<u>S</u>	<u>T R</u>

12-18-2000 16:23:27

Manda R. Conway
REGISTER OF DEEDS

Register of Deeds Stamp & File Number

4. Lot No. _____, Recorded Plat _____
5. Private Claims _____

I, Terry B. Smith, in a field survey on Dec. 4, 2000 do hereby state that under requirements of P.A. 74, Michigan P.A. of 1970, the corner points mentioned in lines 1 and 2 above were in conformance with regulations and rules therefore as required in the current manual of survey instructions of the United States Department of the Interior, Bureau of Land Management or by a decree of a Court of Law and /or that the corner points mentioned in lines 3, 4 and 5 above were in conformance with the rules of the Michigan Board of Land Surveyors or by a Decree of a Court of Law; established, re-established, monumented, recovered, found as expressed below:

NOTE: Not more than 2 corners, all in the same town and range, may be recorded on this certificate.

A	B	C	D	E	F	G	H	I	J	K	L	M
1												
2	6		5		4		3		2		1	
3												
4	7		8		9		10		11		12	
5												
6	18		17		16		15		14		13	
7												
8	19		20		21		22		23		24	
9												
10	30		29		28		27		26		25	
11												
12	31		32		33		34		35		36	
13												

A. Description of original monument and accessories and/or subsequent restoration:


1857 GLO set temporary corner
1905 B. L. Caulkin, County Surveyor
1999 certificate A. Ranger
1972 certificate L. Gerschbacher

B. Description of corner evidence found and/or method applied in restoring or reestablishing corner:

found "T" stake in E-W fence per Liber 524 page 558
peer group -- locally accepted corner

C. Description of monument for corner and accessories established to perpetuate locating the position of the corner:

set Antrim County Monument beside "T" post
fence post West 2.50
fence post East 25.39
30" Maple S40E 84.90
6" Apple N80E 105.20

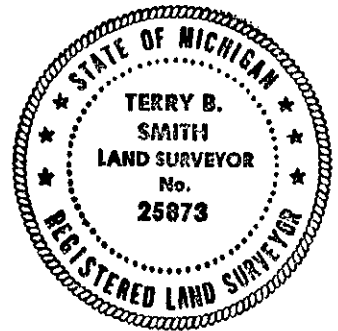

Ratified by Peer Group
In accordance with
P.A. 345
Antrim Co. Chairman

Arthur L. Lennox
Arthur L. Lennox, P.E., P.S.
Nov. 28, 2000

Signed by TB Smith
Surveyor's Michigan License No. 25873

Date 12-18-2000