

SURVEY &
REMONUMENTATION

MAR 05 1998

SECTION

ARENAC COUNTY REMONUMENTATION
LAND CORNER RECORDATION CERTIFICATE
Filing Requirement of Act 74, Mich. P.A. 1970

For corners in

Page 1 of 1
ROSE SMITH
LC 2/ 133
ARENAC CO. REG. OF DEEDS
Rec. Date 12/23/97 Time 11:40
RECORDING FEES: 9.00

Arenac
(County)

Located In:

Corner Code: L-5

1. Public Land Survey T 18N R 4E L-5
T R
T R
T R
2. Property Controlling S T R
in Section S T R
3. Miscellaneous S T R
Property in Sec. S T R

Register of Deeds Stamp & File Number

4. Lot No. , Recorded Plat

5. Private Claims

I, MICHAEL J. MACDONALD, in a field survey on SEPTEMBER 12, 1997 do hereby state that under requirements of P.A. 74, Michigan P.A. of 1970, the corner points mentioned in lines 1 and 2 above were in conformance with regulations and rules therefore as required in the current manual of survey instructions of the United States Department of the Interior, Bureau of Land Management or by a decree of a Court of Law and /or that the corner points mentioned in lines 3, 4 and 5 above were in conformance with the rules of the Michigan Board of Land Surveyors or by a Decree of a Court of Law; established, re-established, monumented, recovered, found as expressed below:

	A	B	C	D	E	F	G	H	I	J	K	L	M
1													
2		6		5		4		3		2		1	
3													
4		7		8		9		10		11		12	
5													
6		18		17		16		15		14		13	
7													
8		19		20		21		22		23		24	
9													
10		30		29		28		27		26		25	
11													
12		31		32		33		34		35		36	
13													

NOTE: Not more than 2 corners, all in the same town and range, may be recorded on this certificate.

A. DESCRIPTION OF ORIGINAL MONUMENT AND ACCESSORIES AND/OR SUBSEQUENT RESTORATION:

L-5

- ORIGINAL POST SET IN JULY 1843, J. BURT D.S.
HEMLOCK 9" S 18 1/2° E 14 LKS.
W. PINE 20" N 42° W 19 LKS.
- COUNTY SURVEY NOTES, JULY 1911, NO CORNER FOUND, SET PINE POST
- SURVEY, L. 1, P. 76, MCGINNIS (1973):
FOUND 3/8" REROD
NORTH 37.45' TO FENCE POST
SW 115.24' TO POWER POLE
S 19° E 49.20' TO NAIL 6" PINE
- SURVEY, L.2, P. 43, MEYERS (1993):
FOUND 3/8" REROD
NORTH 42.35' TO NAIL AND TAG IN 12" WHITE PINE
N 35° W(47.55 M.) TO POWER POLE
N 5° W 40.45' (40.40' M.) TO WHITE PINE
S 30° W 38.87' TO 16" POPLAR
- LCRC, L. 2, P. 110, KOCH, 1995, FND 3/8" REROD
N 10° E 42.39' PK NAIL AND TAG IN WEST SIDE OF 18" PINE
S 51° E 55.78' NAIL AND TAG IN NORTH SIDE OF 18" POPLAR
S 10° W 40.43' N/T IN NORTH SIDE OF 20" PINE
N 51° W 66.29' N/T IN NE SIDE OF 18" PINE

B. Description of corner evidence found and/or method applied in restoring or reestablishing corner:

L-5

FOUND A 3/8" IRON PER WITNESSES FROM SURVEY L.2, P119. EXCAVATED THE AREA AND FOUND NO OTHER OBJECTS. ACCEPTED THE 3/8" IRON AS THE BEST AVAILABLE EVIDENCE OF THE LOCATION OF THE ORIGINAL CORNER.

C. Description of monument for corner and accessories established to perpetuate locating the position of the corner:


L-5

REPLACED 3/8" IRON WITH 5/8" x 24" REROD WITH ARENAC CO. REMONUMENTATION CAP WITH 1/8" DRILL HOLE.
N 10° E 42.35' (42.39' R.) PK NAIL AND TAG IN WEST SIDE OF 18" PINE
S 51° E 55.81' (55.78' R.) NAIL AND TAG IN NORTH SIDE OF 18" POPLAR
N 51° W 66.34' (66.29' R.) N/T IN NE SIDE OF 18" PINE
S 10° W 40.51' (40.43' R.) N/T IN NORTH SIDE OF 20" PINE
N 30° W 48.18' SET N/T IN SW FACE UP
S 50° W 85.64' FND MDOT TAG NW FACE 18"

ACCEPTED BY THIS ARENAC COUNTY
SURVEY PEER GROUP AS THE OFFICIAL
CORNER UNDER MICHIGAN PUBLIC ACT
345 OF 1990 AT "A" MEETING HELD ON
10/30/97
Paul M. Ciosek
PAUL M. CIOSEK, P.S., CHAIRMAN

Signed by Michael J. MacDonald

Surveyor's Michigan License No. 22438
FIELD BOOK 2, PAGE 49

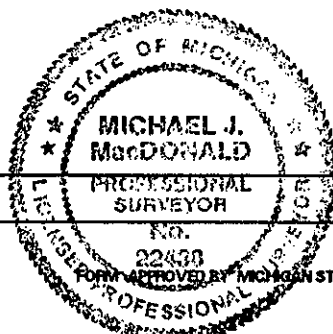

Date 12 Dec 97