

# LAND CORNER RECORDATION CERTIFICATE

Filing Requirement of Act 74, Mich. PA 1970

For Corners In:

Arenac

(County)

Located In

Corner Code #

1. Public Land Survey

T 20N R 05E A10  
T 20N R 04E M10

2. Property Controlling  
in Section

S T R  
S T R

3. Miscellaneous  
Property in Section

S T R  
S T R

4. Lot No:

Recorded Plat:

5. Private Claims:

I, Joshua R. Davidson, in a field survey on September 29, 2014 do hereby state that under requirements of PA 74, Michigan PA of 1970, the corner points mentioned in lines 1 and 2 above were in conformance with regulations and rules therefore as required in the current manual of survey instructions of the United States Department of the Interior, Bureau of Land Management or by a decree of a Court of Law and/or that the corner points mentioned in lines 3, 4 and 5 above were in conformance with the rules of the Michigan Board of Land Surveyors or by a Decree of a Court of Law; established, re-established, monumented, recovered, found as expressed below:

**NOTE: Not more than 2 corners, all in the same town and range, may be recorded on this certificate.**



201600534

DOC#: 201600534

February 29, 2016 10:45 AM

Fee: \$14.00


Darlene Mikkola  
Register of Deeds  
Arenac County, MI

Page 1 of 1

CD

ARENAC CO, 2/29/2016 10:45 AM

Register of Deeds Stamp & File Number

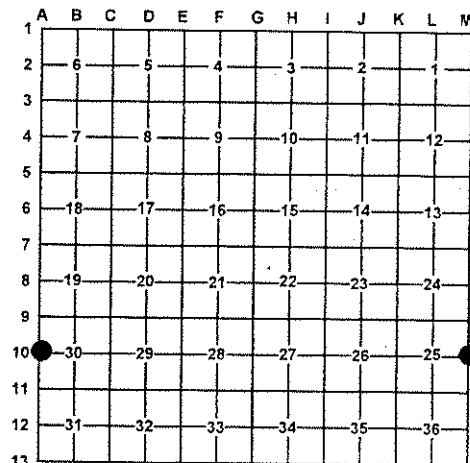

A. Description of original monument and accessories and/or subsequent restoration:

**A10 – M10 – quarter corner common to section 30, T20N, R5E, & section 25, T20N, R4E**

- 1837 – GLO – L. Clason – Marked for quarter section corner Elm 12" on W. side of Brook 8 links W of SE bank.
- 1957 – MDOT corner record – Final Survey notes Control No. 06052 R – set ½" iron rod on E-W fence line & on line btw. Sec. cors. – 1) 8" Ash N86°W 56.84'; 2) 11" Elm N42°E 63.34'; 3) 9" Elm S51°E 53.58'.
- 1983 – Certificate of Survey L. 1, P.491 – R. Miller, PS # 16050 – no corner description. – 4) S30°E 34.45' E. end culvert; 5) West 36.75' F.P.; 6) East 33' ½" rod; 7) S30°W 37.53' W. end Culvert.

B. Description of corner evidence found and/or method applied in restoring or re-establishing corner:

**A10 – M10 – quarter corner common to section 30, T20N, R5E, & section 25, T20N, R4E**

Found ½" X 17' smooth iron bar in centerline North-South gravel road, and in line with old E-W fence. Found accessories #4 & #7, and remains of #1 & #3 fitting position. Accepted location of ½" X 17' smooth iron bar as a careful and faithful reestablishment of the position of the original corner, and replaced it with a 3" stamped brass cap on 5/8" X 24" rebar.

C. Description of monument for corner and accessories established to perpetuate locating the position of the corner:

**A10 – M10 – 3" stamped brass cap on 5/8" X 24" rebar**

N80°E 52.20' to set nail & tag in S. side 9" Oak  
S20°E 34.12' to set Mag nail in East end CMP (#4)  
S28°W 36.43' to set Mag nail in West end CMP (#7)  
West 33.05' To found ½" rebar & cap # 43061  
N42°W 42.87' to set nail & tag in SW. side 7" Aspen

Signed by:

*Joshua R. Davidson*

Date:

February 24, 2016

Surveyor's Michigan License No.:

46659

