

LAND CORNER RECORDATION CERTIFICATE

Authority: 1970 PA 74, MCL 54.205

Surveyor's Name: Stephan J. Szyszkoski

Field Survey Date: October 4, 2017

For corner(s) in: Baraga County

Original Public Land Survey Corner

Corner Code


a. S T 48N R 31W
a. S T 49N R 31W
b. S T 48N R 31W
b. S T 49N R 31W

E01 (GCDB 300700)
E13 (GCDB 300100)
D01 (GCDB 240700)
D13 (GCDB 240100)

Property Corner

1/16 Corner Code

S T R
S T R
S T R
S T R

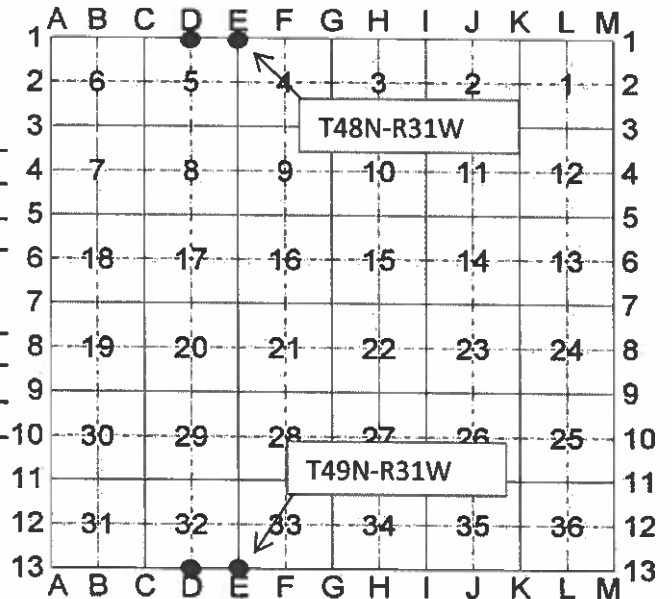

Part A. Corner History

a. Section corner common to Sections 4 and 5, T48N-R31W and Sections 32-33 T49N-R31W. 1846 - Established by John Burt Deputy Surveyor 80.00 chains east and west of adjacent Section corners, on the Township Line. Set Maple post. Cedar 15" N15°E 35 links, Sugar 10" N39°W 43 links. Undated Mead Corp. township index of corners for T49N-R31W shows corner monumented by "post". No detail given.

b. Quarter corner common to Section 5 T48N-R31W and Section 32 T49N-R31W. 1846 - Established by John Burt, Deputy Surveyor midway and on the Township Line between Section corners 40.00 chains east and west. Set Hemlock post. Fir 6" N30°E 35 links, Y.Birch 12" N25°W 19 links. Undated Mead Corp. township index of corners for T49N-R31W notes "BT" and "post" at corner.

Part B: Surveyor's Report on Perpetuation, Restoration, Reestablishment, or Monumentation of Corner

a. Remonumented the original corner position at the position of the rotted remains of a wood post, with a newer wood post found adjacent, found at record bearing and distance from what is very probably the original Cedar BT N15°E 35 links, still alive. The Cedar displays old blazes and paint dating back, by ring count, approx. to the early 1950's but no original marks were identified. From the position monumented, the remains of the OBT Sugar N39°W 43 links, now a rotted stump, were found at substantial record bearing and distance.

b. Remonumented the corner position at the location of 2 old rotted post points, found adjacent, extending deep into the wet soil. From the corner monumented, the likely remains of the OBT Y.Birch N25°W 19 links were recovered and identified as being Y.Birch by cellular analysis, at record bearing and distance. No markings were found on the stump, which appears to be windthrown, is in very poor condition, and is sinking into the swamp. Distance East to an original corner was found to be 2617.63 feet (recorded as 2640 feet in the original survey).

Part C: Field Evidence of Perpetuation or Monumentation of Corner

a. Set 1"IDx28" I.pipe with 2" alum. MDNR cap.
Set measuring nail with MDNR tag in the side of:
14" Cedar N13°E 23.75' mrkd "S33 NBT"
7" Sugar N59°E 9.55' do
12" Sugar S64°W 6.95' "S5 NBT"
9" Sugar N60°W 24.5' "S32 NBT"
Set sq'd cedar post adjacent.
E= 7908061.59 N= 201773.02

b. Set 1"IDx28" I.pipe with 2" alum. MDNR cap
driven onto the end of a 3.5' long picket so that
the cap projects 6" above the water.
Set measuring nail with MDNR tag in the side of:
4" B.Spruce N52°W 35.1' mrkd "1/4S NBT"
2" Cedar N25°E 30.6' do
3" B.Spruce S31°E 27.25' do
9" B.Spruce S64°W 23.35' do
Set sq'd cedar post adjacent.
E= 7907263.89 N= 201779.43

Bearings are magnetic. Coordinates are MCS83 in meters, NAD83(2011) Epoch 2010.00 datum

Stephan J. Szyszkoski

02/05/2018



Professional Surveyor's License No.: 33986

page 1 of 1

Prepared By: S.J. Szyszkoski for the Michigan Dept. of Natural Resources, 427 N. US41 Baraga, MI 49908