

LAND CORNER RECORDATION CERTIFICATE

FILING REQUIREMENT OF ACT 74, MICH. P.A.1970

FOR CORNERS OF—:	LOCATED IN—:	CORNER CODE NUMBER
1. PUBLIC LAND SURVEY _____	T. 48 N. R. 33 E. <input checked="" type="checkbox"/>	K5, L5
2. PROPERTY CONTROLLING IN SECTION _____	T. 48 N. R. 33 E. <input checked="" type="checkbox"/>	15, 16
3. MISCELLANEOUS PROPERTY IN SECTION _____	T. _____ N. R. _____ E. <input type="checkbox"/>	
4. LOT NO. _____, RECORDED PLAT _____		
5. PRIVATE CLAIMS _____		

REGISTER OF DEEDS STAMP AND
FILING NUMBER

I, Keith L. Sackett do hereby certify that under requirements of P.A. 74, Michigan P.A. of 1970, the corner points mentioned in lines 1 and 2 above (identified with circles on index code diagram—over) were, in a field survey on See below 19____, established, re-established, monumented, re-monumented, recovered or restored as expressed below and in conformance with regulations and rules therefore as required in the current manual of survey instructions of the United States Department of the Interior, Bureau of Land Management or by a decree of a court of law. Furthermore, that the corner points mentioned in lines 3, 4 and 5 above were, in a field survey on _____ 19____, found, recovered, restored, established or re-established as expressed below and in conformance with the rules of the Michigan State Board of Registration for Land Surveyors or, by a Decree of a Court of law:

A. Description of original monument and accessories and/or subsequent restoration:

Corner K5: Original monument and accessories not found. Found old scribe post recently witnessed by unknown persons.

Corner 15: Not set on original survey or subsequently apparently.

Corner L5: Original corner and accessories not found.

Corner 16: Not set on original survey or subsequently apparently.

B. Description of corner evidence found and/or method applied in restoring or re-establishing corner:

Corner K5: Re-established 7-31-75 at location of old scribe post.
Corner fits good with other corners in area.

Corner 15: Established 8-7-75 on line between section corner west and $\frac{1}{4}$ corner east.

Corner L5: Re-established 8-7-75 on line between section corners.

Corner 16: Established 8-7-75 on line between $\frac{1}{4}$ corner west and section corner east.

C. Description of monument for corner and accessories established to perpetuate locating the position of the corner:

Corner K5: 1" I.D. x 36" iron pipe with 4" aluminum cap.
9" Sugar S71°E (Mag.) 12.9 ft. S13, NBT
8" " S40°W (Mag.) 7.5 ft. S14, NBT
7" " N61°W (Mag.) 17.6 ft. S11, NBT
Corner 15: Set 1" I.D. x 36" iron pipe with 4" aluminum cap.
7" Cedar N10°W (Mag.) 18.9 ft. S1/16, BT
7" " S80°E (Mag.) 20.3 ft. S1/16, BT
Corner L5: Set 1" I.D. x 36" iron pipe with 4" aluminum cap.
12" Tamarack N27°W (Mag.) 28.6 ft. 1/4S, NBT
6" Spruce S73°W (Mag.) 12.5 ft. 1/4S, NBT
Corner 16: Set 1" I.D. x 36" iron pipe with 4" aluminum cap.
7" W. Birch N73°W (Mag.) 9.5 ft. 1/16S, BT
14" Cedar M42°E (Mag.) 23.4 ft. 1/16S, BT

SIGNED BY _____ DATE _____

SURVEYOR'S MICHIGAN REGISTRATION NO. _____

(SEAL)

FOR STATE AND UNITED STATES AGENCIES:

SIGNED BY _____ DATE _____

APPROVED AND SIGNED BY _____ DATE _____

Keith L. Sackett
MICHIGAN REGISTERED LAND SURVEYOR
Department of Natural Resources

SURVEYOR'S MICHIGAN REGISTRATION NO. 19006

CORNER NUMBERING CODE DIAGRAMS FOR IDENTIFYING LAND CORNER RECORDATIONS AND INDEXING

FOR PUBLIC LAND SURVEY CORNERS IN THE
T. 48N , R. 33W (MENTIONED OVER)


A 12x12 grid with columns labeled A through M and rows labeled 1 through 12. The grid contains numbers 1 through 36, arranged in a pattern that suggests a 6x6 grid of 2x2 blocks. The numbers are as follows:

	A	B	C	D	E	F	G	H	I	J	K	L	M
1													
2		6		5		4		3		2		1	
3													
4		7		8		9		10		11		12	
5											11	12	
6		18		17		16		15		14		13	
7													
8		19		20		21		22		23		24	
9													
10		30		29		28		27		26		25	
11													
12		31		32		33		34		35		36	
13													

Two circles are drawn around the numbers 11 and 12 in row 5, column K.

Apply letter prefix for corner points encircled above
for identifying corner recordation numbers over.

FOR PROPERTY CONTROLLING AND MISC.
PROPERTY CORNERS WITHIN THE SECTION
(MENTIONED OVER AND EXCLUDE LOT CORNER).

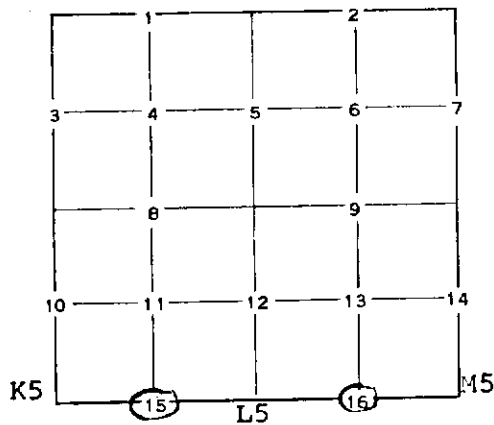

1. Above coded numbers are positioned on 1/16 fractional lines of the section.
2. Township corner code numbers shall be applied to corners of above typical section not numbered.
3. Miscellaneous property corners within a section, located at points other than numbered above, shall be referenced to at least two of above corner code numbers.
4. Private claim corners to be tied to rectangular land corners if possible – sketch required below.

EXPLANATORY SKETCH IF NECESSARY -- BELOW

EX-100

1968

1969

1970

<