

LAND CORNER RECORDATION CERTIFICATE
Filing Requirement of Act 74, Mich. P.A. 1970 as Amended

For corners in

Baraga

(County)

Located In:

Corner Code #

1. Public Land Survey

T 48N R 33W

L13

T R

T R

S T R

2. Property Controlling
in Section

S T R

S T R

3. Miscellaneous
Property in Sec.

S T R

S T R

4. Lot No. , Recorded Plat

5. Private Claims

May 18 2005

I, Stephan J. Szyszkoski

, in a field survey on , 20 do hereby state that under requirements of P.A. 74, Michigan P.A. of 1970, the corner points mentioned in lines 1 and 2 above were in conformance with regulations and rules therefore as required in the current manual of survey instructions of the United States Department of the Interior, Bureau of Land Management or by a decree of a Court of Law and /or that the corner points mentioned in lines 3, 4 and 5 above were in conformance with the rules of the Michigan Board of Land Surveyors or by a Decree of a Court of Law; established, re-established, monumented, recovered, found as expressed below:

NOTE: Not more than 2 corners, all in the same town and range, may be recorded on this certificate.

A. Description of original monument and accessories and/or subsequent restoration:

(L13) Quarter corner common to Section 36 T48N-R33W and Section 1 T47N-R33W. 1846 - Established by Austin Burt, Deputy Surveyor: West on South side of Section 36 ...40.00 Set Fir post Qr. Section corner. Hemlock 28 N27E 30, Spruce 20 N40W 22. ...80.00 Section corner.

B. Description of corner evidence found and/or method applied in restoring or reestablishing corner:

(L13) The original post and accessories were not recovered. Reestablished the corner on the Township line and midway between Section Corner 2639.07' West and Township corner 2639.07' East.

C. Description of monument for corner and accessories established to perpetuate locating the position of the corner:

(L13) Set 1"IDx32" I.pipe with 4" alum.

MDNR cap. Set measuring nails in:

5" Spruce N34E 16.8' mrkd "1/4S NBT"

14" Cedar S16E 32.9' do


17" W.Pine S71W 35.7' do

14" Y.Birch N38W 30.9' do

Set sq'd Spruce post adjacent. Bearings

are magnetic. Distances are to nail

with tag.

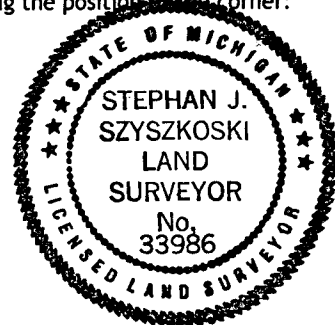

Signed by

Stephan J. Szyszkoski

Date

7/27/05

Surveyor's Michigan License No.

33986

For the Michigan Department of Natural Resources, Office of Land and Facilities

FORM APPROVED BY MICHIGAN STATE BOARD OF PROFESSIONAL SURVEYORS, JAN. 28, 1971

Revised May 14, 1975

Revised Jan., 1983

Revised Oct., 1995