

LAND CORNER RECORDATION CERTIFICATE
Filing Requirement of Act 74, Mich. P.A. 1970 as Amended

For corners in

Baraga (County)	Located In:	Corner Code #
1. Public Land Survey	T _____ R _____ T _____ R _____ T _____ R _____	_____
2. Property Controlling in Section	S 36 T 48N R 34W S 36 T 48N R 34W S _____ T _____ R _____	12 9 _____
3. Miscellaneous Property in Sec.	S _____ T _____ R _____ S _____ T _____ R _____	_____
4. Lot No. _____, Recorded Plat _____		
5. Private Claims		

Register of Deeds Stamp & File Number

	A	B	C	D	E	F	G	H	I	J	K	L	M
1													
2	6		5		4		3		2		1		
3													
4	7		8		9		10		11		12		
5													
6	18		17		16		15		14		13		
7													
8	19		20		21		22		23		24		
9													
10	30		29		28		27		26		25		
11													
12	31		32		33		34		35		36		
13													

I, Stephan J. Szyszkoski, in a field survey on 06/08/2011 do hereby state that under requirements of P.A. 74, Michigan P.A. of 1970, the corner points mentioned in lines 1 and 2 above were in conformance with regulations and rules therefore as required in the current manual of survey instructions of the United States Department of the Interior, Bureau of Land Management or by a decree of a Court of Law and /or that the corner points mentioned in lines 3, 4 and 5 above were in conformance with the rules of the Michigan Board of Land Surveyors or by a Decree of a Court of Law; established, re-established, monumented, recovered, found as expressed below:

NOTE: Not more than 2 corners, all in the same town and range, may be recorded on this certificate.

A. Description of original monument and accessories and/or subsequent restoration:

(12-Sec. 36) South 1/16 corner of Section 36. Not established in the original survey.

(9-Sec. 36) East 1/16 corner, Section 36. Not established in the original survey.

B. Description of corner evidence found and/or method applied in restoring or reestablishing corner:

(12-Sec. 36) Established the corner midway and on a straight line between Quarter corner 1314.87' South and Center of Section 36 1314.87' North.

(9-Sec. 36) Established the corner midway and on a straight line between Quarter corner 1318.97' East and Center of Section 36 1318.97' West.

C. Description of monument for corner and accessories established to perpetuate locating the position of the corner:

(12) Set 1"IDx32" I.pipe with 4" alum. MDNR cap.
Set measuring nail with MDNR tag in the side of:
12" Hemlock N06W 18.4'
5" Sugar S51E 15.05'
14" Maple S15E 16.55'
6" Sugar N89W 6.15'
Set sq'd cedar post adjacent.
Bearings are magnetic.

(9) Set 1"IDx32" I.pipe with 4" alum. MDNR cap.
Set measuring nail with MDNR tag in the side of:
11" Maple S79E 5.1' mrkd "1/16S BT"
11" Maple S10E 15.85' do
18" W.Pine N70W 4.25' do
11" Maple N44W 8.5' do
Set sq'd Cedar post adjacent.
Bearings are magnetic.

Signed by

Stephan J. Szyszkoski


Date

06/29/2011

Surveyor's Michigan License No.

33986

For the Michigan Department of Natural Resources, Forest Management Division

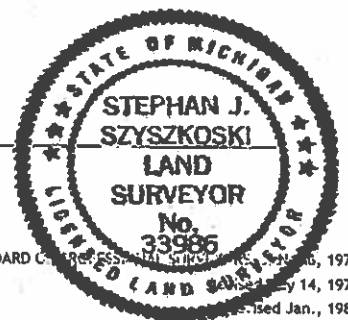

16636

16638